

SURVEY & REMONUMENTATION

MAR 03 1998

KENT COUNTY REMONUMENTATION

SECTION

LAND CORNER RECORDATION CERTIFICATE
Filing Requirement of Act 74, Mich. P.A. 1970

For corners in

KENT COUNTY

(County)

Located In:

Corner Code #

- 1. Public Land Survey T 5N R 9W C-4
- T R
- T R
- T R
- T R
- 2. Property Controlling in Section S T R
- S T R
- 3. Miscellaneous S T R
- S T R
- S T R

STATE OF MICHIGAN
COUNTY OF KENT
RECEIVED FOR RECORD

97 JUN -3 AM 8:12

REG. OF DEEDS

10002

Register of Deeds Stamp & File Number

- 4. Lot No. _____, Recorded Plat _____
- 5. Private Claims _____

I, Kirk Breitels, in a field survey on Apr. 14, 1997 do hereby state that under requirements of P.A. 74, Michigan P.A. of 1970, the corner points mentioned in lines 1 and 2 above were in conformance with regulations and rules therefore as required in the current manual of survey instructions of the United States Department of the Interior, Bureau of Land Management or by a decree of a Court of Law and /or that the corner points mentioned in lines 3, 4 and 5 above were in conformance with the rules of the Michigan Board of Land Surveyors or by a Decree of a Court of Law; established, re-established, monumented, recovered, found as expressed below:

NOTE: Not more than 2 corners, all in the same town and range, may be recorded on this certificate.

	A	B	C	D	E	F	G	H	I	J	K	L	M
1													
2	6		5		4		3		2		1		
3													
4	7		8		9		10		11		12		
5													
6	18		17		16		15		14		13		
7													
8	19		20		21		22		23		24		
9													
10	30		29		28		27		26		25		
11													
12	31		32		33		34		35		36		
13													

A. Description of original monument and accessories and/or subsequent restoration:

- | | | | | |
|-----|------|-------------------|------------|--------------------------|
| C-4 | 1830 | GLO | Mullett | Set Post |
| | 1963 | Kent Co. Wit. | | 3/4" Iron |
| | 1977 | LCRC #967 & #1036 | Ankrom | 3/4" Pipe |
| | 1981 | LCRC #2099 | Merdzinski | 3/4" Iron Pipe |
| | 1982 | LCRC #2666 | Bonnema | Set Kent County Monument |
| | 1990 | LCRC #5340 | Starr | Kent County Monument |

The position of this corner was previously approved by the Kent County Remonumentation Peer Group, monumented by Douglas W. Bonnema on 2/1/9/82 and was recorded per LCRC #2666

B. Description of corner evidence found and/or method applied in restoring or reestablishing corner:


C-4 Found BROKEN standard Kent Co. Mon. (Harrison) per witnesses from above LCRC as set by Douglas W. Bonnema in place of the 1/2" Iron he found. Said Iron checks with LCRC's #967, #1036, #2099 and Exxel Eng. records. RESET standard Kent Co. Mon. per witnesses. LCRC #2666 LCRC #5340

- | | | | | |
|---------------------|---------------|--------------------|---------------|--------------|
| Nail & tag 6" Elm | N10°W 145.74' | Nail & tag P. Pole | S72°E 178.24' | Capped Rerod |
| Nail & tag 6" Ash | N85°W 38.04' | Nail & tag 12" Elm | N14°W 145.77' | S88°E |
| Nail & tag T. Pole | S15°E 116.78' | Nail & tag 8" Ash | N79°W 38.04' | 33.00' |
| Nail & tag P. Pole | S75°E 177.0' | Nail & tag T. Pole | S10°E 116.83' | |
| SE corner brk. hse. | S45°W 192.15' | SE cor. brk. hse. | S45°W 192.22' | |

The selected location is accepted by me and is generally accepted by professional surveyors as the best available evidence of the position of the original corner.

C. Description of monument for corner and accessories established to perpetuate locating the position of the corner:

- C-4 Standard Kent County Monument (wits. by EDM)
- Nail & KC Remon. tag N. side P. Pole S72°E 178.06'
 - Nail & KC Remon. tag W. side 14" Elm N14°W 145.77'
 - Nail & KC Remon. tag N. side 10" Hickory N79°W 37.98'
 - Nail & KC Remon. tag W. side T. Pole S10°E 116.78'
 - SE corner brick house #7201 S45°W 192.15'
 - Capped Rerod (All Points) East 32.92'
 - Capped Rerod (Roosien) West 32.99'
- C/L Morse Lake Ave. is W. 5'± & Tree line to W. is 10'± N.

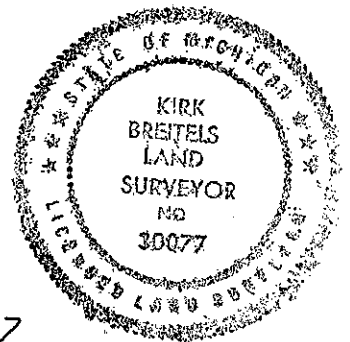

Signed by Kirk Breitels
Surveyor's Michigan License No. 30077

Date 5/22/97

P.A. 345 1990 KENT COUNTY
PEER APPROVED 5/22/97
CHAIRMAN [Signature]