

**SURVEY & REMONUMENTATION**

KENT COUNTY REMONUMENTATION

MAR 03 1998

**LAND CORNER RECORDATION CERTIFICATE**  
Filing Requirement of Act 74, Mich. P.A. 1970

For corners in SECTION

KENT COUNTY

(County)


Located In:

Corner Code #

1. Public Land Survey	T	5N	R	9W	C-7
	T		R		
	T		R		
	T		R		
2. Property Controlling In Section	S		T	R	
	S		T	R	
3. Miscellaneous Property in Sec.	S		T	R	
	S		T	R	

STATE OF MICHIGAN  
COUNTY OF KENT  
RECEIVED FOR RECORD  
97 APR 29 AM 8:17  
REG. OF DEEDS  
*Luc St. Land*  
9715  
Register of Deeds Stamp & File Number

4. Lot No. \_\_\_\_\_, Recorded Plat \_\_\_\_\_  
5. Private Claims \_\_\_\_\_

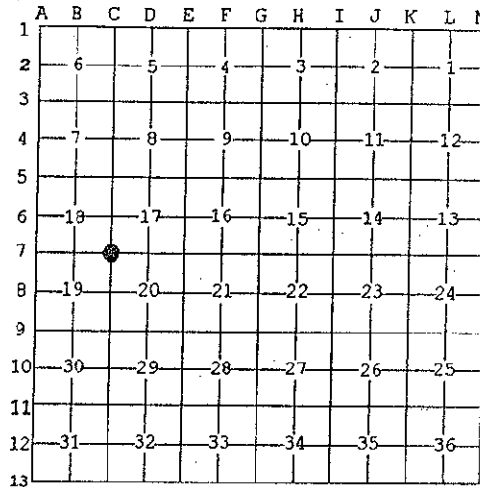

I, Kirk Breitels, in a field survey on Jan. 24, 1997 do hereby state that under requirements of P.A. 74, Michigan P.A. of 1970, the corner points mentioned in lines 1 and 2 above were in conformance with regulations and rules therefore as required in the current manual of survey instructions of the United States Department of the Interior, Bureau of Land Management or by a decree of a Court of Law and/or that the corner points mentioned in lines 3, 4 and 5 above were in conformance with the rules of the Michigan Board of Land Surveyors or by a Decree of a Court of Law; established, re-established, monumented, recovered, found as expressed below.

NOTE: Not more than 2 corners, all in the same town and range, may be recorded on this certificate.

A. Description of original monument and accessories and/or subsequent restoration:

C-7	1830	GLO	Mullett	Set Post
		Kent Co. Wit.		Iron in Mon. Box
	1972	LCRC #138	D. Scott	1" Iron Pipe in Mon. Box
	1981	LCRC #1811	Bonnema	3/4" Iron in Mon. Box
	1981	LCRC #2497	Bonnema	Set Kent County Monument in Mon. Box
	1990	LCRC #5343	Starr	Kent County Monument

The position of this corner was previously approved by the Kent County Remonumentation Peer Group, monumented by Douglas W. Bonnema on 11/25/81 and was recorded per LCRC #2497

B. Description of corner evidence found and/or method applied in restoring or reestablishing corner:

C-7 Found standard Kent Co. Mon. (Harrison) per witnesses from above LCRC as set by Douglas W. Bonnema in place of the 1" Iron he found inside a Mon. Box. Said Iron checks with Kent Co. Wit. and LCRC's #138 & #1811.

LCRC #2497	36" Oak	S10°E 133.51'	LCRC #5343	36" Oak	S69°E 154.09'	36" Oak	S11°E 133.52'
	Nail & tag 36" Oak	S70°E 154.10'		Fc. post	S40°E 47.03'	S. Pole	S27°W 99.89'
	Nail & tag School bldg.	S40°E 70.90'		Top C/L gas line marker	S52°W 55.03'		
	C/L gas line marker	S50°W 55.04'		Nail & tag top curb	N65°W 45.71'		
	Nail & tag top curb	N65°W 45.71'		Nail & tag top curb	N30°E 43.37'		

The selected location is accepted by me and is generally accepted by professional surveyors as the best available evidence of the position of the original corner.

C. Description of monument for corner and accessories established to perpetuate locating the position of the corner:

C-7	Standard Kent County Monument		
	Nail & KC Remon. tag SW side corner fence post	S40°E	47.03'
	Nail & KC Remon. tag NW side Service Pole	S27°W	99.84'
	Top C/L 2" gas pipeline marker	S52°W	55.03'
	Nail & KC Remon. tag N. side 40" Oak	S69°E	154.09'
	Nail & KC Remon. tag W. side 40" Oak	S11°E	133.52'
	PK Nail N. side Power Pole	N65°W	134.03'
	Nail & KC Remon. tag SE cor. fence post	N50°E	70.14'
	On C/L "X" 84th St. and Morse Lake Ave.		



Signed by *Kirk Breitels*  
Surveyor's Michigan License No. 30077

Date 3/27/97

P.A. 345 1990 KENT COUNTY

PEER APPROVED 3/27/97  
CHAIRMAN *Humphreys*