

**SURVEY & REMONUMENTATION**

MAR 03 1998

**KENT COUNTY REMONUMENTATION**

**LAND CORNER RECORDATION CERTIFICATE**  
Filing Requirement of Act 74, Mich. P.A. 1970

REG. OF DEEDS

97 APR 29 AM 8:17

STATE OF MICHIGAN  
COUNTY OF KENT  
RECEIVED FOR RECORD

9716

Register of Deeds Stamp & File Number

For corners in SECTION  
KENT COUNTY

Located In:	Corner Code #
T 5N R 9W	C-8
T R	
T R	
T R	
T R	
S T R	
S T R	
S T R	
S T R	

1. Public Land Survey

2. Property Controlling in Section

3. Miscellaneous Property in Sec.

4. Lot No. \_\_\_\_\_, Recorded Plat \_\_\_\_\_  
5. Private Claims \_\_\_\_\_

I, Kirk Breitels, in a field survey on Jan. 17, 1997 do hereby state that under requirements of P.A. 74, Michigan P.A. of 1970, the corner points mentioned in lines 1 and 2 above were in conformance with regulations and rules therefore as required in the current manual of survey instructions of the United States Department of the Interior, Bureau of Land Management or by a decree of a Court of Law and/or that the corner points mentioned in lines 3, 4 and 5 above were in conformance with the rules of the Michigan Board of Land Surveyors or by a Decree of a Court of Law; established, re-established, monumented, recovered, found as expressed below:

NOTE: Not more than 2 corners, all in the same town and range, may be recorded on this certificate.

	A	B	C	D	E	F	G	H	I	J	K	L	M
1													
2	6		5		4		3		2		1		
3													
4	7		8		9		10		11		12		
5													
6	18		17		16		15		14		13		
7													
8	19		20		21		22		23		24		
9													
10	30		29		28		27		26		25		
11													
12	31		32		33		34		35		36		
13													

A. Description of original monument and accessories and/or subsequent restoration:

Date	Description	Witness	Monument
C-8 1830	GLO	Mullett	Set Post Monument
1939-68	Kent Co. Wit.		Set Kent County Monument in Mon. Box
1984	LCRC #4059	Jonker	Kent County Monument in Mon. Box
1990	LCRC #5344	Starr	

The position of this corner was previously approved by the Kent County Remonumentation Peer Group, monumented by Robert J. Jonker on 12/14/84 and was recorded per LCRC #4059


B. Description of corner evidence found and/or method applied in restoring or reestablishing corner:  
C-8 Found standard Kent Co. Mon. (Harrison) per witnesses from above LCRC as set by Robert J. Jonker in place of the 3/4" Round Iron he found inside a Mon. Box. Said Iron checks with Kent Co. Wit.

Monument	LCRC #5344	Bearing	Distance
Remon. tag fence post	Nail & tag Serv. Pole	N54°E	54.32'
Remon. tag 8" Elm	Nail & tag dbl. 4"-6" Pine	S36°W	64.68'
Remon. tag 6" Pine	Nail & tag 10" Pine	S16°W	136.03'
Remon. tag 6" Pine	Nail & tag cor. fc. post	S88°E	33.68'
C/L top steel fc. post	C/L top steel fc. post	N26°W	69.85'

The selected location is accepted by me and is generally accepted by professional surveyors as the best available evidence of the position of the original corner.

C. Description of monument for corner and accessories established to perpetuate locating the position of the corner:

Monument	Bearing	Distance
C-8 Standard Kent County Monument in Mon. Box	N54°E	54.32'
Nail & KC Remon. tag NW side Service Pole	S36°W	64.98'
Nail & KC Remon. tag NW side dbl. 6"-10" Pines	S16°W	135.85'
Nail & KC Remon. tag NW side 14" Pine	N90°E	77.21'
Nail & KC Remon. tag N. side fence post	N26°W	69.95'
Top C/L steel fence post		
Corner is in C/L blacktop road N-S		

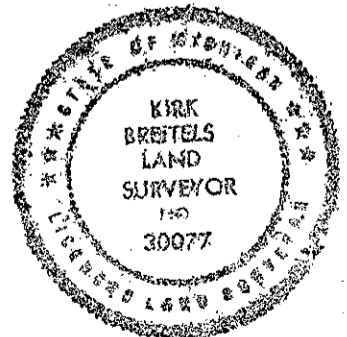

Signed by Kirk Breitels  
Surveyor's Michigan License No. 30077

Date 3/27/97

P.A. 345 1990 KENT COUNTY  
PEER APPROVED 3/27/97  
CHAIRMAN [Signature]