

SURVEY & REMONUMENTATION

MAR 03 1998

KENT COUNTY REMONUMENTATION

LAND CORNER RECORDATION CERTIFICATE
Filing Requirement of Act 74, Mich. P.A. 1970

For corners in **SECTION**

<u>KENT COUNTY</u> (County)	Located In:	Corner Code #
1. Public Land Survey	T 5N R 9W	C-9
	T ___ R ___	_____
	T ___ R ___	_____
	T ___ R ___	_____
2. Property Controlling in Section	S ___ T ___ R ___	_____
	S ___ T ___ R ___	_____
3. Miscellaneous Property in Sec.	S ___ T ___ R ___	_____
	S ___ T ___ R ___	_____

STATE OF MICHIGAN
 COUNTY OF KENT
 RECEIVED FOR RECORD
 97 JUN -3 AM 8:12
 REG. OF DEEDS
 10004
 Register of Deeds Stamp & File Number

4. Lot No. _____, Recorded Plat _____
 5. Private Claims _____

I, Kirk Breitels, in a field survey on Apr. 14, 1997 do hereby state that under requirements of P.A. 74, Michigan P.A. of 1970, the corner points mentioned in lines 1 and 2 above were in conformance with regulations and rules therefore as required in the current manual of survey instructions of the United States Department of the Interior, Bureau of Land Management or by a decree of a Court of Law and/or that the corner points mentioned in lines 3, 4 and 5 above were in conformance with the rules of the Michigan Board of Land Surveyors or by a Decree of a Court of Law; established, re-established, monumented, recovered, found as expressed below:

NOTE: Not more than 2 corners, all in the same town and range, may be recorded on this certificate.

A	B	C	D	E	F	G	H	I	J	K	L	M
1												
2	6	5	4	3	2	1						
3												
4	7	8	9	10	11	12						
5												
6	18	17	16	15	14	13						
7												
8	19	20	21	22	23	24						
9												
10	30	29	28	27	26	25						
11												
12	31	32	33	34	35	36						
13												

A. Description of original monument and accessories and/or subsequent restoration:

C-9	1830	GLO	Mullett	Set Post
	1967	Williams & Works		Iron
	1968	Kent Co. Wit.		"T" Iron
	1986	LCRC #4421	Jonker	Set Kent County Monument in Mon. Box
	1990	LCRC #5345	Starr	Kent County Monument

The position of this corner was previously approved by the Kent County Remonumentation Peer Group, monumented by Robert J. Jonker on 4/8/86 and was recorded per LCRC #4421.

B. Description of corner evidence found and/or method applied in restoring or reestablishing corner:


C-9 Found standard Kent Co. Mon. (Harrison) per witnesses from above LCRC as set by Robert J. Jonker in place of the 1" Iron he found inside a Mon. Box. Said Iron checks with Kent Co. Wit. and Williams & Works information.

LCRC #4421		LCRC #5345	
Remon. tag P. Pole	N40°E 92.94'	Nail & tag P. Pole	N38°E 92.96'
Remon. tag T. Pole	S50°E 63.10'	Nail & tag T. Pole	S48°E 63.08'
Remon. tag T. & P Pole	S75°W 90.10'	Nail & tag Util. Pole	S75°W 90.11'
Remon. tag P. Pole	N45°W 116.2'	Nail & tag P. Pole	N45°W 116.25'
Remon. tag Fence post	S40°W 57.0'	Nail & tag fence post	S37°W 56.72'

The selected location is accepted by me and is generally accepted by professional surveyors as the best available evidence of the position of the original corner.

C. Description of monument for corner and accessories established to perpetuate locating the position of the corner:

C-9	Standard Kent County Monument in Mon. Box
Nail & KC Remon. tag NW side P. Pole	N38°E 92.93'
Nail & KC Remon. tag NE side Tel. Pole	S48°E 63.08'
Nail & KC Remon. tag N. side stump Pole	S75°W 90.07'
Nail & KC Remon. tag SW side new P. Pole	N25°W 83.72'
On C/L N-S & E-W asphalt roads.	

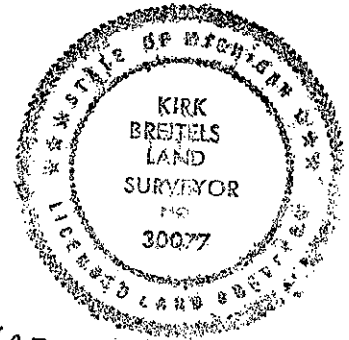

Signed by Kirk Breitels
 Surveyor's Michigan License No. 30077

Date 5/22/97

P.A. 345 1990 KENT COUNTY
 PEER APPROVED 5/22/97
 CHAIRMAN Harry Huber