

SURVEY & REMONUMENTATION

MAR 03 1998

KENT COUNTY REMONUMENTATION

LAND CORNER RECORDATION CERTIFICATE
Filing Requirement of Act 74, Mich. P.A. 1970

SECTION

For corners in
KENT COUNTY

(County)

Located In: Corner Code #

- | | | |
|------------------------------------|-----------|------|
| 1. Public Land Survey | T 5N R 9W | C-10 |
| | T R | |
| | T R | |
| | T R | |
| 2. Property Controlling in Section | S T R | |
| | S T R | |
| 3. Miscellaneous Property in Sec. | S T R | |
| | S T R | |

STATE OF MICHIGAN
 COUNTY OF KENT
 RECEIVED FOR RECORD
 97 APR 29 AM 8:17
 REG. OF DEEDS
[Signature]

9717

Register of Deeds Stamp & File Number

4. Lot No. _____, Recorded Plat _____
 5. Private Claims _____

I, Kirk Breitels, in a field survey on Jan. 17, 1997 do hereby state that under requirements of P.A. 74, Michigan P.A. of 1970, the corner points mentioned in lines 1 and 2 above were in conformance with regulations and rules therefore as required in the current manual of survey instructions of the United States Department of the Interior, Bureau of Land Management or by a decree of a Court of Law and for that the corner points mentioned in lines 3, 4 and 5 above were in conformance with the rules of the Michigan Board of Land Surveyors or by a Decree of a Court of Law, established, re-established, monumented, recovered, found as expressed below:

NOTE: Not more than 2 corners, all in the same town and range, may be recorded on this certificate.

A	B	C	D	E	F	G	H	I	J	K	L	M
1												
2	6	5	4	3	2	1						
3												
4	7	8	9	10	11	12						
5												
6	18	17	16	15	14	13						
7												
8	19	20	21	22	23	24						
9												
10	30	29	28	27	26	25						
11												
12	31	32	33	34	35	36						
13												

A. Description of original monument and accessories and/or subsequent restoration:

C-10	1830	GLO	Mullett	Set Post
		Kent Co. Wit.		Mon. Box
	1972	LCRC #233	Spicer	1 1/2" Iron in Mon. Box
	1981	LCRC #2488	Bonnema	Set Kent County Monument in Mon. Box
	1990	LCRC #5346	Starr	Kent County Monument in Mon. Box

The position of this corner was previously approved by the Kent County Remonumentation Peer Group, monumented by Douglas W. Bonnema on 11/25/81 and was recorded per LCRC #2488

B. Description of corner evidence found and/or method applied in restoring or reestablishing corner:


C-10 Found standard Kent Co. Mon. (Harrison) per witnesses from above LCRC as set by Douglas W. Bonnema in place of the 1 1/2" Iron he found inside a Mon. Box. Said Iron checks with Kent Co. Wit. and LCRC #233.

<u>LCRC #2488</u>		<u>LCRC #5346</u>
SW corner garage	N20°E 95.98'	Nail & tag 8" Cherry S45°W 40.73'
Nail & tag dbl. 14" Oak	West 37.33'	SW cor. block garage N23°E 95.98'
Nail & tag 8" Elm	N85°E 30.47'	Nail & tag dbl. 16" Oak S88°W 37.27'
Nail & tag 6" Cherry	S55°W 40.83'	Nail & tag 10" Elm N86°E 30.92'
NW cor. conc. floor brdg.	S20°E 118.15'	NW cor. conc. bridge S15°E 118.14'

The selected location is accepted by me and is generally accepted by professional surveyors as the best available evidence of the position of the original corner.

C. Description of monument for corner and accessories established to perpetuate locating the position of the corner:

C-10 Standard Kent County Monument	
Nail & KC Remon. tag SE side 10" Cherry	S45°W 40.73'
SW corner block garage	N23°E 95.98'
Nail & KC Remon. tag N. side dbl. 24" Oak	S88°W 37.22'
Nail & KC Remon. tag N. side 12" Elm (dead)	N86°E 30.92'
NW cor. of West conc. bridge approach	S15°E 118.18'
Fence line West, tree line East & West	
C/L blacktop road is East 1.0'±	

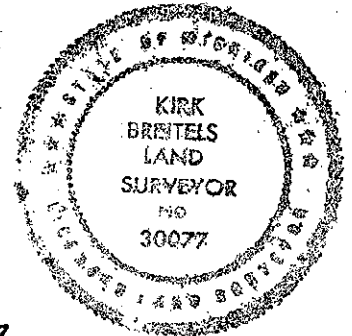

Signed by *Kirk Breitels*
 Surveyor's Michigan License No. 30077

Date 3/27/97

P.A. 345 1990 KENT COUNTY
 PEER APPROVED 3/27/97
 CHAIRMAN *Danny Hubers*