

**SURVEY & REMONUMENTATION**

MAR 03 1998

KENT COUNTY REMONUMENTATION

**SECTION LAND CORNER RECORDATION CERTIFICATE**  
Filing Requirement of Act 74, Mich. P.A. 1970

For corners in  
KENT COUNTY

(County)

Located In:

Corner Code #

1. Public Land Survey

T 5N R 9W D-2

2. Property Controlling in Section

3. Miscellaneous Property in Sec.

S	T	R	
S	T	R	
S	T	R	
S	T	R	

4. Lot No. \_\_\_\_\_, Recorded Plat \_\_\_\_\_

5. Private Claims \_\_\_\_\_

I, Kirk Breitels, in a field survey on Sept. 8, 1997 do hereby state that under requirements of P.A. 74, Michigan P.A. of 1970, the corner points mentioned in lines 1 and 2 above were in conformance with regulations and rules therefore as required in the current manual of survey instructions of the United States Department of the Interior, Bureau of Land Management or by a decree of a Court of Law and /or that the corner points mentioned in lines 3, 4 and 5 above were in conformance with the rules of the Michigan Board of Land Surveyors or by a Decree of a Court of Law; established, re-established, monumented, recovered, found as expressed below:

NOTE: Not more than 2 corners, all in the same town and range, may be recorded on this certificate.

A. Description of original monument and accessories and/or subsequent restoration:

D-2	1830	GLO	Mullett	Not Set
		Williams & Works		No Information
		Kent Co. Wits.		No Information

P.A. 345 1990 KENT COUNTY  
PEER APPROVED 9/29/97  
CHAIRMAN Harry Huber

B. Description of corner evidence found and/or method applied in restoring or reestablishing corner:

D-2 Established Intersection of 1/4 lines and found nothing.  
Fence to South is 5' West.

The Intersection of 1/4 lines is accepted by me and is generally accepted by professional surveyors as the best available evidence of the position of the corner.

C. Description of monument for corner and accessories established to perpetuate locating the position of the corner:

D-2 Set Standard Kent Co. Monument (Harrison) at the Intersection of 1/4 lines.


Nail & KC Remon. tag E. side 12" Cherry	N05°W	10.85'
Nail & KC Remon. tag N. side 12" Poplar	N70°W	30.40'
Nail & KC Remon. tag W. side 30" Oak	S10°W	8.85'
Nail & KC Remon. tag N. side 14" Hickory	S90°E	39.30'
Nail & KC Remon. tag SW side 18" Oak	S45°E	41.52'

STATE OF MICHIGAN  
COUNTY OF KENT  
RECEIVED FOR RECORD  
97 NOV 13 PM 1:00  
REG. OF DEEDS  
*David Bond*

10260

Register of Deeds Stamp & File Number

1	A	B	C	D	E	F	G	H	I	J	K	L	M
2		6		5		4		3		2		1	
3													
4		7		8		9		10		11		12	
5													
6		18		17		16		15		14		13	
7													
8		19		20		21		22		23		24	
9													
10		30		29		28		27		26		25	
11													
12		31		32		33		34		35		36	
13													

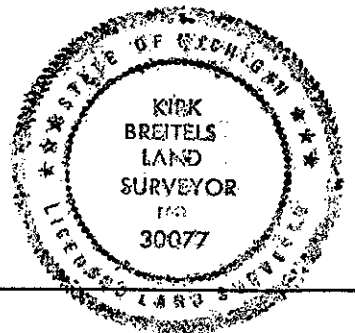

Signed by Kirk Breitels  
Surveyor's Michigan License No. 30077

Date 10/30/97