

**SURVEY & REMONUMENTATION**

MAR 03 1998

KENT COUNTY REMONUMENTATION

**LAND CORNER RECORDATION CERTIFICATE**  
Filing Requirement of Act 74, Mich. P.A. 1970

SECTION

For corners in  
KENT COUNTY  
(County)

Located In:	Corner Code #
T 5N R 9W	D-3
T R	
T R	
T R	
S T R	
S T R	
S T R	
S T R	

REG. OF DEEDS

*Handwritten signature*


97 APR 29 AM 8:17

STATE OF MICHIGAN  
COUNTY OF KENT  
RECEIVED FOR RECORD

9722

Register of Deeds Stamp & File Number

- Public Land Survey
- Property Controlling in Section
- Miscellaneous Property in Sec.
- Lot No. \_\_\_\_\_, Recorded Plat \_\_\_\_\_
- Private Claims \_\_\_\_\_

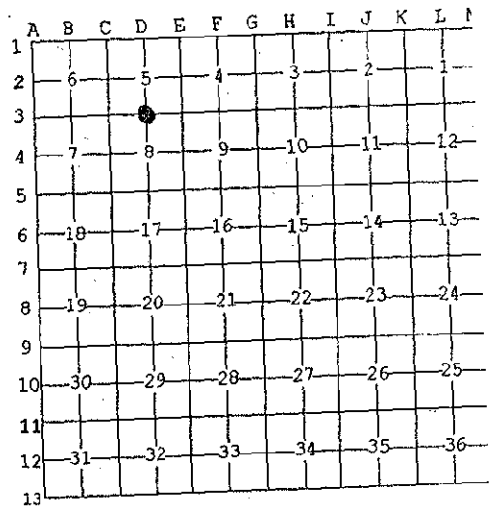

I, Kirk Breitels, in a field survey on Jan. 17, 1997 do hereby state that under requirements of P.A. 74, Michigan P.A. of 1970, the corner points mentioned in lines 1 and 2 above were in conformance with regulations and rules therefore as required in the current manual of survey instructions of the United States Department of the Interior, Bureau of Land Management or by a decree of a Court of Law and for that the corner points mentioned in lines 3, 4 and 5 above were in conformance with the rules of the Michigan Board of Land Surveyors or by a Decree of a Court of Law; established, re-established, monumented, recovered, found as expressed below:

NOTE: Not more than 2 corners, all in the same town and range, may be recorded on this certificate.

A. Description of original monument and accessories and/or subsequent restoration:

Date	Location	Monument	Material
D-3 1830	GLO	Mullett	Set Post
1906	Surveyor's Office		Stone
1981	LCRC #2099	Merdzinski	Rebar
1982	LCRC #2852	Jonker	Set Kent County Monument
1990	LCRC #5350	Starr	Kent County Monument

The position of this corner was previously approved by the Kent County Remonumentation Peer Group, monumented by Robert J. Jonker on 5/14/82 and was recorded per LCRC #2852

B. Description of corner evidence found and/or method applied in restoring or reestablishing corner:

D-3 Found standard Kent Co. Mon. (Harrison) per witnesses from above LCRC as set by Robert J. Jonker in place of the Capped Rerod he found. Said Rerod checks with LCRC #2099.

LCRC #2852	LCRC #5350
Remon. tag 8" Ash	Nail & tag Tw. 4" Elm
Remon. tag 6" Tw. Hick.	Nail & tag dbl. 3"-6" Hick.
Remon. tag 6" Elm	Nail & tag dbl. 4"-8" Elm
Remon. tag 3" Elm	Nail & tag Tw. 6" Hickory
	Nail & tag 6" Elm

The selected location is accepted by me and is generally accepted by professional surveyors as the best available evidence of the position of the original corner.

C. Description of monument for corner and accessories established to perpetuate locating the position of the corner:

Monument	Material
D-3 Standard Kent County Monument	
Nail & KC Remon. tag NW side Twin 6" Elm	N57°E 40.23'
Nail & KC Remon. tag E. side dbl. 3"-6" Hickory	S03°W 42.52'
Nail & KC Remon. tag N. side dbl. 4"-12" Elm	S61°E 85.79'
Nail & KC Remon. tag SW side Twin 8" Hickory	S43°E 49.51'
Nail & KC Remon. tag W. side 8" Elm	N06°W 31.25'
C/L E-W blacktop road is 2'± North	
On fence & tree line to North and West edge woods to South	



Signed by Kirk Breitels  
Surveyor's Michigan License No. 30077

Date 3/27/97

P.A. 345 1990 KENT COUNTY  
PEER APPROVED 3/27/97  
CHAIRMAN Handwritten signature