

**SURVEY & REMONUMENTATION**

MAR 03 1998

**KENT COUNTY REMONUMENTATION**

**SECTION**

**LAND CORNER RECORDATION CERTIFICATE**  
Filing Requirement of Act 74, Mich. P.A. 1970

STATE OF MICHIGAN  
COUNTY OF KENT  
RECEIVED FOR RECORD  
97 NOV 13 PM 1:00  
REG. OF DEEDS  
*Lucy Bond*

For corners in  
**KENT COUNTY**

Located In:	Corner Code #
T 5N R 9W	D-4
T R	
T R	
T R	
T R	
S T R	
S T R	
S T R	
S T R	

10261

Register of Deeds Stamp & File Number

- Public Land Survey
- Property Controlling in Section
- Miscellaneous Property in Sec.
- Lot No. \_\_\_\_\_, Recorded Plat \_\_\_\_\_
- Private Claims \_\_\_\_\_

I, Kirk Breitels, in a field survey on Sept. 12 97, do hereby state that under requirements of P.A. 74, Michigan P.A. of 1970, the corner points mentioned in lines 1 and 2 above were in conformance with regulations and rules therefore as required in the current manual of survey instructions of the United States Department of the Interior, Bureau of Land Management or by a decree of a Court of Law and for that the corner points mentioned in lines 3, 4 and 5 above were in conformance with the rules of the Michigan Board of Land Surveyors or by a Decree of a Court of Law; established, re-established, monumented, recovered, found as expressed below:

1	A	B	C	D	E	F	G	H	I	J	K	L	M
2		6		5		4		3		2		1	
3													
4		7		8		9		10		11		12	
5													
6		18		17		16		15		14		13	
7													
8		19		20		21		22		23		24	
9													
10		30		29		28		27		26		25	
11													
12		31		32		33		34		35		36	
13													

NOTE: Not more than 2 corners, all in the same town and range, may be recorded on this certificate.

A. Description of original monument and accessories and/or subsequent restoration:  
D-4 1830---GLO---Not Set  
1906---Williams & Works---Found & Accepted Stone and Iron  
Kent Co. Wits---No Information for corner (meas. shown)

P.A. 345 1990 KENT COUNTY  
PEER APPROVED 9/25/97  
CHAIRMAN Harry Huber


B. Description of corner evidence found and/or method applied in restoring or reestablishing corner:  
D-4 Found nothing at vicinity of corner. Established intersection of 1/4 lines and found fence corner for fences E-W-S to be 2' N. and 4' W. Many stones and rocks around fence corner (location of 1906 Iron ?).

Intersection of 1/4 lines agrees with measurements and angles ± of a 1988 Medema & VanKooten survey in the NW 1/4.

The Intersection of 1/4 lines is accepted by me and is generally accepted by professional surveyors as the best available evidence of the position of the corner.

C. Description of monument for corner and accessories established to perpetuate locating the position of the corner:  
D-4 Set Kent County Monument (Harrison) at the Intersection of 1/4 lines.

Nail & KC Remon. tag E. side 12" Elm	N25°W	11.27'
Nail & KC Remon. tag S. side 14" Maple	S70°W	41.17'
Nail & KC Remon. tag N. side 36" Cherry	S30°W	43.72'
Nail & KC Remon. tag NE side 12" Oak	S35°E	20.83'
Rerod (offset iron)	N85°W	8.73'
Rerod (offset iron)	N10°W	4.96'

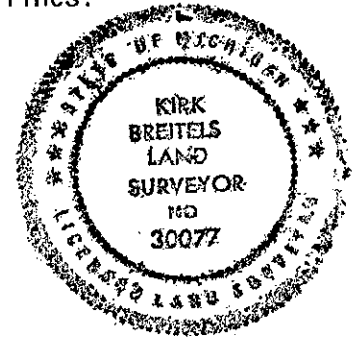

Signed by Kirk Breitels  
Surveyor's Michigan License No. 30077

Date 10/30/97