

SURVEY & REMONUMENTATION

APR 27 1995

COMMISSION

Kent County Remonumentation
LAND CORNER RECORDATION CERTIFICATE
 Filing Requirement of Act 74, Mich. P.A. 1970

STATE OF MICHIGAN
 COUNTY OF KENT
 RECEIVED FOR RECORD
 94 DEC 30 PM 12:06

For corners in

<u>Kent County</u> (County)	Located in: Bowne Twp.	Corner Code # D-8
1. Public Land Survey	T <u>5N</u> R <u>9W</u>	_____
	T _____ R _____	_____
	T _____ R _____	_____
	T _____ R _____	_____
2. Property Controlling in Section	S _____ T _____ R _____	_____
	S _____ T _____ R _____	_____
3. Miscellaneous Property in Sec.	S _____ T _____ R _____	_____
	S _____ T _____ R _____	_____
4. Lot No. _____, Recorded Plat _____		
5. Private Claims _____		

W. J. Jonker
 REG. OF DEEDS

7970

Register of Deeds Stamp & File Number

A	B	C	D	E	F	G	H	I	J	K	L	M
2	6	5	4	3	2	1						
3												
4	7	8	9	10	11	12						
5												
6	18	17	16	15	14	13						
7												
8	19	20	21	22	23	24						
9												
10	30	29	28	27	26	25						
11												
12	31	32	33	34	35	36						
13												

I, Robert Jonker, in a field survey on December 21, 1994, do hereby certify that under requirements of P.A. 74, Michigan P.A. of 1970, the corner points mentioned in lines 1 and 2 above were in conformance with regulations and rules therefore as required in the current manual of survey instructions of the United States Department of the Interior, Bureau of Land Management or by a decree of a Court of Law and/or that the corner points mentioned in lines 3, 4 and 5 above were in conformance with the rules of the Michigan Board of Land Surveyors or by a Decree of a Court of Law; established, re-established, monumented, re-monumented, recovered, found as expressed below:


NOTE: Not more than 4 corners, all in the same town and range, may be recorded on this certificate.

A. Description of original monument and accessories and/or subsequent restoration:
 Not set in GLO survey.
 No info. available from W & W and orther survey firms.
 1987, LCRC #4510, Chuck Fricke, P.S. #21781,
 He found no evidence of existing corner & set corner @ int. of 1/4 lines
 1/2" iron rod
 Nail NW side 9" Pine N 40° E 12.8' P.A. 345 1990 KENT COUNTY
 Nail W. side 15" W.Cherry S 19° E 27.7' PEER APPROVED 12/22/94
 Nail SE side 8" Mulberry S 28° W 10.7' CHAIRMAN *Harry Thuker*
 Nail W. side 5" Hickory N 46° W 7.7'

B. Description of corner evidence found and/or method applied in restoring or reestablishing corner:
 Found 1/2" iron rod by wit. listed above for LCRC #4510
 Calculate position to be 0.5' South & 0.1' West of int. of 1/4 lines.

This position not established by original government surveyors. This monument is accepted as the best available evidence of the position of the corner.

C. Description of monument for corner and accessories established to perpetuate locating the position of the corner:
 Replaced with 4" x 30" standard K.C. Harrison monument.
 K.C. N&T E. side 8" Mulberry S 30° W 10.66'
 K.C. N&T E. side 12" Jackpine N 40° E 12.85'
 K.C. N&T E. side 12" Hickory N 50° W 7.49'
 K.C. N&T E. side 24" W.Cherry S 20° E 28.42'
 N-S fence is 33' West
 E-W fence is 34' South

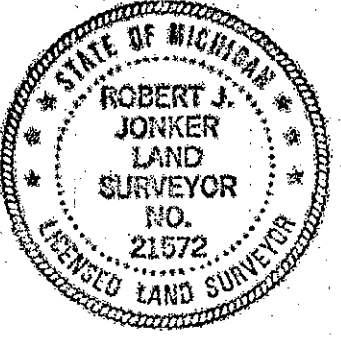

Signed by Robert J. Jonker
 JONKER LAND SURVEYS, P.C. 21572
 Surveyor's Michigan License No.

Date December 28, 1994