

**SURVEY & REMONUMENTATION**

MAR 03 1998

**KENT COUNTY REMONUMENTATION**

**LAND CORNER RECORDATION CERTIFICATE**  
Filing Requirement of Act 74, Mich. P.A. 1970

For corners in **SECTION**  
**KENT COUNTY**  
(County)

Located In:	Corner Code #
1. Public Land Survey T 5N R 9W	D-13
T R	
T R	
T R	
2. Property Controlling in Section S T R	
S T R	
3. Miscellaneous Property in Sec. S T R	
S T R	

4. Lot No. \_\_\_\_\_, Recorded Plat \_\_\_\_\_  
5. Private Claims \_\_\_\_\_

I, Kirk Breitels, in a field survey on Jan. 28, 1997 do hereby state that under requirements of P.A. 74, Michigan P.A. of 1970, the corner points mentioned in lines 1 and 2 above were in conformance with regulations and rules therefore as required in the current manual of survey instructions of the United States Department of the Interior, Bureau of Land Management or by a decree of a Court of Law and /or that the corner points mentioned in lines 3, 4 and 5 above were in conformance with the rules of the Michigan Board of Land Surveyors or by a Decree of a Court of Law; established, re-established, monumented, recovered, found as expressed below:

NOTE: Not more than 2 corners, all in the same town and range, may be recorded on this certificate.

STATE OF MICHIGAN  
 COUNTY OF KENT  
 RECEIVED FOR RECORD  
 97 APR 29 AM 8:18  
 REG. OF DEEDS  
*Lucy Standa*

**9727**

Register of Deeds Stamp & File Number

1	A	B	C	D	E	F	G	H	I	J	K	L	M
2		6		5		4		3		2		1	
3													
4		7		8		9		10		11		12	
5													
6		16		17		16		15		14		13	
7													
8		19		20		21		22		23		24	
9													
10		30		29		28		27		26		25	
11													
12		31		32		33		34		35		36	
13													

A. Description of original monument and accessories and/or subsequent restoration:

D-13	1830	GLO	Mullett	Set Post
	1981	LCRC #1838	Bonnema	Set Capped Rerod
	1982	LCRC #2851	Jonker	Set Kent County Monument
	1990	LCRC #5355	Starr	Kent County Monument

The position of this corner was previously approved by the Kent County Remonumentation Peer Group, monumented by Robert J. Jonker on 5/17/82 and was recorded per LCRC #2851

B. Description of corner evidence found and/or method applied in restoring or reestablishing corner:

D-13 Found standard Kent Co. Mon. (Harrison) per witnesses from above LCRC as set by Robert J. Jonker in place of the Capped Rerod he found. Said Capped Rerod checks with LCRC #1838.


<u>LCRC #2851</u>	Iron West	12.18'	<u>LCRC #5335</u>	Iron West	12.18'
Remon. tag 12" Oak	N60°E	40.1'	Nail & tag 12" Oak	N60°E	40.04'
Remon. tag 9" Oak	N40°W	46.0'	Nail & tag 9" Oak	N40°W	45.96'
Remon. tag 9" Oak	S25°W	26.48'	Nail & tag 9" Oak	S25°W	26.62'
Remon. tag 9" Oak	S75°E	12.35'	Nail & tag 9" Oak	S75°E	12.36'
Remon. tag 16" Oak	S15°E	27.59'	Nail & tag 16" Oak	S15°E	27.56'

The selected location is accepted by me and is generally accepted by professional surveyors as the best available evidence of the position of the original corner.

C. Description of monument for corner and accessories established to perpetuate locating the position of the corner:

D-13 Standard Kent County Monument

Nail & KC Remon. tag NW side	16" Oak	N60°E	40.04'
Nail & KC Remon. tag SW side	12" Oak	N40°W	46.04'
Nail & KC Remon. tag W. side	9" Oak	S25°W	26.62'
Nail & KC Remon. tag N. side	9" stump	S75°E	12.40'
Nail & KC Remon. tag NE side	20" Oak	S15°E	27.61'
Capped Rerod (Exxel)		West	12.10'
C/L E-W trail is North 8'±			
Fence corner East-West-North is 38'± North			

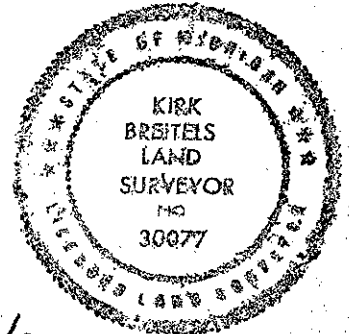

Signed by Kirk Breitels  
Surveyor's Michigan License No. 30077

Date 3/27/97

P.A. 345 1990 KENT COUNTY  
PEER APPROVED 3/27/97  
CHAIRMAN Harry Huber