

**SURVEY & REMONUMENTATION**

**MAR 03 1998**

**KENT COUNTY REMONUMENTATION**

**SECTION**

**LAND CORNER RECORDATION CERTIFICATE**  
**Filing Requirement of Act 74, Mich. P.A. 1970**

For corners in  
KENT COUNTY

(County)

Located In:

Corner Code #

1. Public Land Survey	T <u>5</u> N	R <u>9</u> W	E-1
	T	R	
	T	R	
	T	R	
2. Property Controlling in Section	S	T	R
	S	T	R
3. Miscellaneous Property in Sec.	S	T	R
	S	T	R

STATE OF MICHIGAN  
 COUNTY OF KENT  
 RECEIVED FOR RECORD  
 97 APR 29 AM 8:18  
 REG. OF DEEDS  
*Lucy St. Grand*

**9728**

Register of Deeds Stamp & File Number

4. Lot No. \_\_\_\_\_, Recorded Plat \_\_\_\_\_  
 5. Private Claims \_\_\_\_\_

I, Kirk Breitels, in a field survey on Jan. 9, 1997 do hereby state that under requirements of P.A. 74, Michigan P.A. of 1970, the corner points mentioned in lines 1 and 2 above were in conformance with regulations and rules therefore as required in the current manual of survey instructions of the United States Department of the Interior, Bureau of Land Management or by a decree of a Court of Law and /or that the corner points mentioned in lines 3, 4 and 5 above were in conformance with the rules of the Michigan Board of Land Surveyors or by a Decree of a Court of Law; established, re-established, monumented, recovered, found as expressed below:

NOTE: Not more than 2 corners, all in the same town and range, may be recorded on this certificate.

1	A	B	C	D	E	F	G	H	I	J	K	L	M
2		6		5		4		3		2		1	
3													
4		7		8		9		10		11		12	
5													
6		18		17		16		15		14		13	
7													
8		19		20		21		22		23		24	
9													
10		30		29		28		27		26		25	
11													
12		31		32		33		34		35		36	
13													

A. Description of original monument and accessories and/or subsequent restoration:

E-1	1830	GLO	Mullett	Set Post
		Kent Co. Wit.		Iron
	1974	LCRC #620	Spicer	3/4" Iron
	1986	LCRC #4422	Jonker	Set Kent County Monument on twp. line
	1995	LCRC #8221	Breitels	Kent County Monument

The position of this corner was previously approved by the Kent County Remonumentation Peer Group, monumented by Robert J. Jonker on 4/8/86 and was recorded per LCRC #4422

B. Description of corner evidence found and/or method applied in restoring or reestablishing corner:


E-1 Found standard Kent Co. Mon. (Harrison) per witnesses from above LCRC as set by Robert J. Jonker in place of the 3/4" Iron over top of a conc. mon. he found. Both Iron and conc. mon. check with Kent Co. Wit. and LCRC #620.

<u>LCRC #4422</u>		<u>LCRC #8221</u>		KC Mon.	West	68.60'
Remon. tag T. Pole	S60°E	58.65'	Nail & tag T. Pole	S60°E	58.70'	
Remon. tag P. Pole	N40°E	28.88'	Nail & tag P. Pole	N40°E	28.92'	
C/L NE bolt RR signal	S50°W	61.35'	Nail & tag 42" Oak	N45°W	112.58'	
Kent Co. Mon.	West	68.6'	C/L NE bolt RR signal	S50°W	61.39'	
			PK Nail cor. fc. post	N35°W	44.73'	

The selected location is accepted by me and is generally accepted by professional surveyors as the best available evidence of the position of the original corner.

C. Description of monument for corner and accessories established to perpetuate locating the position of the corner:

E-1 Standard Kent County Monument						
Nail & KC Remon. tag N. side T. Pole	S60°E	58.70'				
Nail & KC Remon. tag W. side P. Pole	N40°E	28.92'				
Nail & KC Remon. tag NE side 42" Oak	N45°W	112.48'				
C/L NE anchor bolt to RR signal base	S50°W	61.39'				
PK Nail SW side corner fence post	N35°W	44.73'				
Kent Co. Mon. (E-13, T6N, R9W)	West	68.60'				

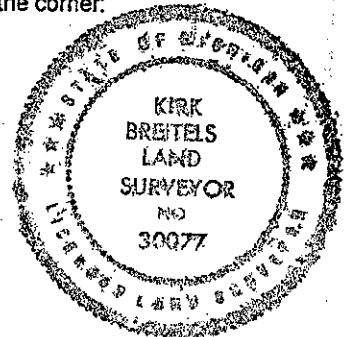

Signed by *Kirk Breitels*  
 Surveyor's Michigan License No. 30077

Date 3/27/97

P.A. 345 1990 KENT COUNTY  
 PEER APPROVED 3/27/97  
 CHAIRMAN *Harry Hubert*