

**SURVEY & REMONUMENTATION**

MAR 03 1998

KENT COUNTY REMONUMENTATION

**SECTION**

**LAND CORNER RECORDATION CERTIFICATE**  
Filing Requirement of Act 74, Mich. P.A. 1970

For corners in  
KENT COUNTY  
(County)

Located In:	Corner Code #
T 5N R 9W	E-2
T R	
T R	
T R	
S T R	
S T R	
S T R	
S T R	

- Public Land Survey
- Property Controlling in Section
- Miscellaneous Property in Sec.

4. Lot No. \_\_\_\_\_, Recorded Plat \_\_\_\_\_  
5. Private Claims \_\_\_\_\_

REG. OF DEEDS  
*Luis St. Paul*  
97 APR 29 AM 8:18  
STATE OF MICHIGAN  
COUNTY OF KENT  
RECEIVED FOR RECORD

9729

Register of Deeds Stamp & File Number

I, Kirk Breitels, in a field survey on Jan. 17, 1997 do hereby state that under requirements of P.A. 74, Michigan P.A. of 1970, the corner points mentioned in lines 1 and 2 above were in conformance with regulations and rules therefore as required in the current manual of survey instructions of the United States Department of the Interior, Bureau of Land Management or by a decree of a Court of Law and/or that the corner points mentioned in lines 3, 4 and 5 above were in conformance with the rules of the Michigan Board of Land Surveyors or by a Decree of a Court of Law; established, re-established, monumented, recovered, found as expressed below:

1	A	B	C	D	E	F	G	H	I	J	K	L	M
2		6		5	•	4		3		2		1	
3													
4		7		8		9		10		11		12	
5													
6		18		17		16		15		14		13	
7													
8		19		20		21		22		23		24	
9													
10		30		29		28		27		26		25	
11													
12		31		32		33		34		35		36	
13													

NOTE: Not more than 2 corners, all in the same town and range, may be recorded on this certificate.

A. Description of original monument and accessories and/or subsequent restoration:

E-2	1830	GLO	Mullett	Set Post
		Kent Co. Wit.		1 1/2" Iron in Mon. Box
	1973	LCRC #620	Spicer	3/4" Iron in Mon. Box
	1976	LCRC #945	Bonnema	3/4" Iron in Mon. Box
	1982	LCRC #2660	Bonnema	Set Kent County Monument in Mon. Box
	1990	LCRC #5356	Starr	Kent County Monument in Mon. Box

The position of this corner was previously approved by the Kent County Remonumentation Peer Group, monumented by Douglas W. Bonnema on 2/19/82 and was recorded per LCRC #2660

B. Description of corner evidence found and/or method applied in restoring or reestablishing corner:


E-2 Found standard Kent Co. Mon. (Harrison) per witnesses from above LCRC as set by Douglas W. Bonnema in place of the 3/4" Iron over 1 1/2" Iron he found inside a Mon. Box. Both Irons check with Kent Co. Wit. and LCRC's #620 & #945.

LCRC #2660	LCRC #5356
Nail & tag 50" Oak N20°W 86.95'	Nail & tag 50" Oak N20°W 85.09'
Nail & tag Hickory N75°E 69.46'	Nail & tag 18" Hickory N75°E 69.48'
NW cor. hse. fnd. N33°E 134.25'	NW cor. hse. fnd. N33°E 134.38'
Nail & tag P. Pole S27°E 76.09'	Nail & tag P. Pole S28°E 76.12'
Nail & tag 14" Hickory N46°W 116.73'	Nail & tag 14" Hickory N45°W 116.86'

The selected location is accepted by me and is generally accepted by professional surveyors as the best available evidence of the position of the original corner.

C. Description of monument for corner and accessories established to perpetuate locating the position of the corner:

E-2 Standard Kent County Monument in Mon. Box	
Nail & KC Remon. tag E. side 56" Oak	N20°W 85.00'
Nail & KC Remon. tag S. side 24" Hickory	N75°E 69.46'
NW corner house (#11201) foundation	N33°E 134.38'
Nail & KC Remon. tag SW side P. Pole	S28°E 76.02'
Nail & KC Remon. tag SW side 20" Hickory	N45°W 116.70'
Corner is 1.5' South of C/L blacktop road to East	
Corner is 1.5' West of C/L N-S blacktop road	

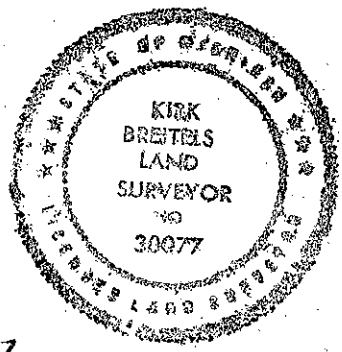

Signed by *Kirk Breitels*  
Surveyor's Michigan License No. 30077

Date 3/27/97

P.A. 345 1990 KENT COUNTY  
PEER APPROVED 3/27/97  
CHAIRMAN *Harry Hubert*