

**SURVEY & REMONUMENTATION**

**KENT COUNTY REMONUMENTATION**

MAR 03 1998

**LAND CORNER RECORDATION CERTIFICATE**  
Filing Requirement of Act 74, Mich. P.A. 1970

For corners in SECTION  
KENT COUNTY Located In: Corner Code #

1. Public Land Survey	T 5N R 9W	E-3
	T R	
	T R	
	T R	
2. Property Controlling in Section	S T R	
	S T R	
3. Miscellaneous Property in Sec.	S T R	
	S T R	


STATE OF MICHIGAN  
COUNTY OF KENT  
RECEIVED FOR RECORD  
97 APR 29 AM 8:18  
REG. OF DEEDS  
*Lucy Bond*

9730

Register of Deeds Stamp & File Number

4. Lot No. \_\_\_\_\_, Recorded Plat \_\_\_\_\_  
5. Private Claims \_\_\_\_\_

I, Kirk Breitels, in a field survey on Jan. 17, 1997 do hereby state that under requirements of P.A. 74, Michigan P.A. of 1970, the corner points mentioned in lines 1 and 2 above were in conformance with regulations and rules therefore as required in the current manual of survey instructions of the United States Department of the Interior, Bureau of Land Management or by a decree of a Court of Law and /or that the corner points mentioned in lines 3, 4 and 5 above were in conformance with the rules of the Michigan Board of Land Surveyors or by a Decree of a Court of Law; established, re-established, monumented, recovered, found as expressed below:

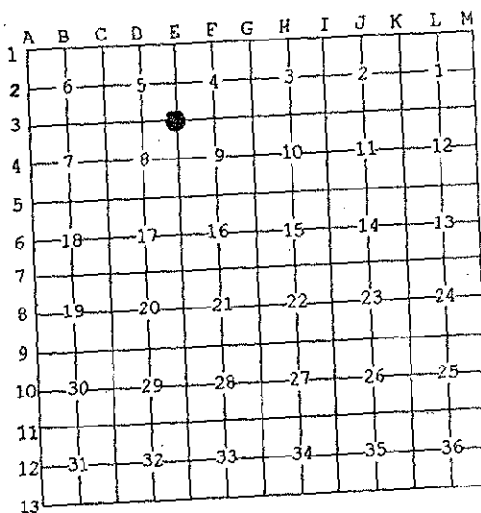

NOTE: Not more than 2 corners, all in the same town and range, may be recorded on this certificate.

A. Description of original monument and accessories and/or subsequent restoration:

E-3	1830	GLO	Mullett	Set Post
	1966	Kent Co. Wit.		3/4" Iron in Mon. Box
	1980	LCRC #2085	Nederveld	3/4" Iron in Mon. Box
	1986	LCRC #4416	Jonker	Set Kent County Monument in Mon. Box
	1990	LCRC #5357	Starr	Kent County Monument in Mon. Box

The position of this corner was previously approved by the Kent County Remonumentation Peer Group, monumented by Robert J. Jonker on 4/8/86 and was recorded per LCRC #4416.


B. Description of corner evidence found and/or method applied in restoring or reestablishing corner:  
E-3 Found standard Kent Co. Mon. (Harrison) per witnesses from above LCRC as set by Robert J. Jonker in place of the 3/4" Iron he found inside a Mon. Box. Said Iron checks with Kent Co. Wit. and LCRC #2085.

<u>LCRC #4416</u>	Remon. tag 12" Apple	N40°E 68.13'	Nail & tag 14" Apple	N40°E 68.15'
	Remon. tag 18" Pine	N70°E 61.15'	Nail & tag 20" Pine	N71°E 61.19'
	Remon. tag 14" Tamarack	S60°E 113.75'	Nail & tag 14" Hemlock	S27°E 113.83'
	Remon. tag T. Pole	S25°W 79.48'	Nail & tag MBT Pole	S25°W 79.48'
	SW cor. hse. siding	S25°E 118.5'	SW cor. house siding	S61°E 118.63'

The selected location is accepted by me and is generally accepted by professional surveyors as the best available evidence of the position of the original corner.

C. Description of monument for corner and accessories established to perpetuate locating the position of the corner:

E-3 Standard Kent County Monument in Mon. Box	N40°E 68.18'
Nail & KC Remon. tag SE side 18" Apple	N71°E 61.22'
Nail & KC Remon. tag N. side 26" Pine	S27°E 114.05'
Nail & KC Remon. tag W. side 18" Hemlock	S25°W 79.48'
Nail & KC Remon. tag W. side MBT Pole	S61°E 118.50'
SW corner house siding	
On C/L blacktop roads N-S-W	

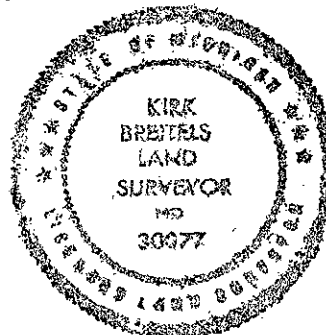

Signed by *Kirk Breitels*  
Surveyor's Michigan License No. 30077

Date 3/27/97

P.A. 345 1990 KENT COUNTY  
PEER APPROVED 3/27/97  
CHAIRMAN *James Hubert*