

SURVEY & REMONUMENTATION KENT COUNTY REMONUMENTATION

MAR 03 1998 LAND CORNER RECORDATION CERTIFICATE
 Filing Requirement of Act 74, Mich. P.A. 1970

For corners in KENT COUNTY SECTION
 Located In: _____ Corner Code # _____
 (County) _____

1. Public Land Survey	T	5N	R	9W	E-10
	T		R		
	T		R		
	T		R		
2. Property Controlling in Section	S		T	R	
	S		T	R	
3. Miscellaneous Property in Sec.	S		T	R	
	S		T	R	

4. Lot No. _____, Recorded Plat _____
 5. Private Claims _____

STATE OF MICHIGAN
 COUNTY OF KENT
 RECEIVED FOR RECORD
 97 APR 29 AM 8:19
 REG. OF DEEDS
Lucy St. Paul

9734

Register of Deeds Stamp & File Number

I, Kirk Breiteis, in a field survey on Jan. 24, 1997 do hereby state that under requirements of P.A. 74, Michigan P.A. of 1970, the corner points mentioned in lines 1 and 2 above were in conformance with regulations and rules therefore as required in the current manual of survey instructions of the United States Department of the Interior, Bureau of Land Management or by a decree of a Court of Law and/or that the corner points mentioned in lines 3, 4 and 5 above were in conformance with the rules of the Michigan Board of Land Surveyors or by a Decree of a Court of Law; established, re-established, monumented, recovered, found as expressed below:

NOTE: Not more than 2 corners, all in the same town and range, may be recorded on this certificate.

	A	B	C	D	E	F	G	H	I	J	K	L	M
1													
2	6		5		4		3		2		1		
3													
4	7		8		9		10		11		12		
5													
6	18		17		16		15		14		13		
7													
8	19		20		21		22		23		24		
9													
10	30		29		28		27		26		25		
11													
12	31		32		33		34		35		36		
13													

A. Description of original monument and accessories and/or subsequent restoration:

E-10	1830	GLO	Mullett	Set Post
	1963	Kent Co. Wit.		3/4" Iron
	1982	LCRC #2935	Bonnema	Bolt Spike in Mon. Box
	1982	LCRC #3137	Bonnema	Set Kent County Monument in Mon. Box
	1990	LCRC #5363	Starr	Kent County Monument

The position of this corner was previously approved by the Kent County Remonumentation Peer Group, monumented by Douglas W. Bonnema on 11/9/82 and was recorded per LCRC #3137

B. Description of corner evidence found and/or method applied in restoring or reestablishing corner:

E-10 Found standard Kent Co. Mon. (Harrison) per witnesses from above LCRC as set by Douglas W. Bonnema in place of the Bolt Spike & 1/2" Iron he found inside a Mon. Box. Said Bolt Spike & 1/2" Iron checks with Kent Co. Wit. and LCRC #2935.

LCRC #3137

Nail & tag 12" Hickory	S47°E	25.48'
Nail & tag 10" Hickory	S57°W	31.35'
Nail & tag 12" Cherry	N13°E	96.02'
Nail & tag 14" Cherry	N90°E	96.38'

LCRC #5363


Nail & tag 8" Hickory	S34°W	54.68'
Nail & tag 12" Hickory	S41°E	25.44'
Nail & tag 10" Hickory	S60°W	31.34'
Nail & tag dbl. 10" Cherry	N17°E	95.94'
Nail & tag 14" Cherry	S88°E	96.55'

The selected location is accepted by me and is generally accepted by professional surveyors as the best available evidence of the position of the original corner.

C. Description of monument for corner and accessories established to perpetuate locating the position of the corner:

E-10 Standard Kent County Monument

Nail & KC Remon. tag NE side 16" Hickory	S41°E	25.41'
Nail & KC Remon. tag W. side 18" Cherry	N17°E	95.96'
Nail & KC Remon. tag N. side 24" Cherry	S88°E	96.38'
Nail & KC Remon. tag NW side P. Pole	S50°W	86.55'
Nail & KC Remon. tag S. side fence cor. post	N90°W	35.11'
On fence & tree lines to East & West		
C/L N-S bit. road is West 2'±		

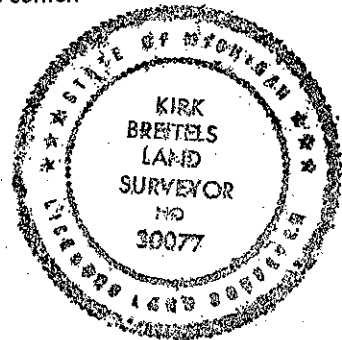

Signed by *Kirk Breiteis*
 Surveyor's Michigan License No. 30077

Date 3/27/97

P.A. 345 1990 KENT COUNTY
 PEER APPROVED 3/27/97
 CHAIRMAN *Harry Ruben*