

SURVEY & REMONUMENTATION

MAR 03 1998

KENT COUNTY REMONUMENTATION

SECTION

LAND CORNER RECORDATION CERTIFICATE
Filing Requirement of Act 74, Mich. P.A. 1970

For corners in

KENT COUNTY

(County)

Located in:

Corner Code #

1. Public Land Survey	T <u>5</u> N	R <u>9</u> W	E-11
	T _____	R _____	_____
	T _____	R _____	_____
	T _____	R _____	_____
2. Property Controlling in Section	S _____	T _____ R _____	_____
	S _____	T _____ R _____	_____
3. Miscellaneous Property in Sec.	S _____	T _____ R _____	_____
	S _____	T _____ R _____	_____

97 JUN -3 AM 8:12
STATE OF MICHIGAN
COUNTY OF KENT
RECEIVED FOR RECORD

REG. OF DEEDS

10007

Register of Deeds Stamp & File Number

4. Lot No. _____, Recorded Plat _____
5. Private Claims _____

I, Kirk Breitels, in a field survey on Apr. 14, 1997 do hereby state that under requirements of P.A. 74, Michigan P.A. of 1970, the corner points mentioned in lines 1 and 2 above were in conformance with regulations and rules therefore as required in the current manual of survey instructions of the United States Department of the Interior, Bureau of Land Management or by a decree of a Court of Law and/or that the corner points mentioned in lines 3, 4 and 5 above were in conformance with the rules of the Michigan Board of Land Surveyors or by a Decree of a Court of Law, established, re-established, monumented, recovered, found as expressed below:

NOTE: Not more than 2 corners, all in the same town and range, may be recorded on this certificate.

1	A	B	C	D	E	F	G	H	I	J	K	L	M
2	6			5		4		3		2		1	
3													
4	7			8		9		10		11		12	
5													
6	10			17		16		15		14		13	
7													
8	19			20		21		22		23		24	
9													
10	30			29		28		27		26		25	
11													
12	31			32		33		34		35		36	
13													

A. Description of original monument and accessories and/or subsequent restoration:

E-11	1830	GLO	Mullett	Set Post
	1963	Kent Co. Wit.		1" Iron
	1977	LCRC #1091	VanKooten	1" Iron in Mon. Box
	1981	LCRC #2490	Bonnema	Set Kent County Monument in Mon. Box
	1990	LCRC #5364	Starr	Kent County Monument

The position of this corner was previously approved by the Kent County Remonumentation Peer Group, monumented by Douglas W. Bonnema on 11/25/81 and was recorded per LCRC #2490

B. Description of corner evidence found and/or method applied in restoring or reestablishing corner:

E-11 Found standard Kent Co. Mon. (Harrison) per witnesses from above LCRC as set by Douglas W. Bonnema in place of the 1" Iron he found inside a Mon. Box. Said Iron checks with Kent Co. Wit. and LCRC #1091.


LCRC #2490	LCRC #5364
KC tag 42" Maple N75°E 70.99'	Nail & tag 12" Cherry N25°E 79.59'
KC tag 10" Crab Apple S75°E 114.44'	Nail & tag 42" Maple N67°E 70.93'
KC tag P. Pole S60°E 103.21'	Nail & tag 10" Crabapple S75°E 114.61'
KC tag 12" Elm South 76.16'	Nail & tag P. Pole S60°E 103.20'
"X" on top of hdwll. N15°W 67.77'	Nail & tag dead 12" Elm S02°W 76.05'
NE cor. RR tie post N40°W 48.52'	

The selected location is accepted by me and is generally accepted by professional surveyors as the best available evidence of the position of the original corner.

C. Description of monument for corner and accessories established to perpetuate locating the position of the corner:

E-11 Standard Kent County Monument

Nail & KC Remon. tag W. side	18" Cherry	N25°E	79.41'
Nail & KC Remon. tag NW side	46" Maple	N67°E	70.93'
Nail & KC Remon. tag N. side	10" Crabapple	S75°E	114.45'
Nail & KC Remon. tag S. side	new P. Pole	S60°E	101.50'
Nail & KC Remon. tag NE side	P. Pole	N50°W	72.94'
On C/L asphalt roads E-W & N.			
On fence and tree line to S.			

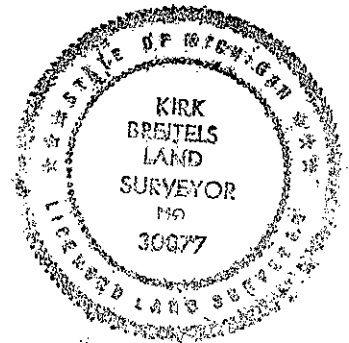

Signed by Kirk Breitels
Surveyor's Michigan License No. 30077

Date 5/22/97

P.A. 345 1990 KENT COUNTY
PEER APPROVED 5/22/97
CHAIRMAN Harrison Huber