

SURVEY & REMONUMENTATION

MAR 03 1998

KENT COUNTY REMONUMENTATION

LAND CORNER RECORDATION CERTIFICATE
Filing Requirement of Act 74, Mich. P.A. 1970

SECTION

For corners in
KENT COUNTY
(County)

Located In:	Corner Code #
T 5N R 9W	E-13
T R	
T R	
T R	
S T R	
S T R	
S T R	
S T R	

1. Public Land Survey

2. Property Controlling in Section

3. Miscellaneous Property in Sec.

4. Lot No. _____, Recorded Plat _____

5. Private Claims _____

STATE OF MICHIGAN
COUNTY OF KENT
RECEIVED FOR RECORD
97 APR 29 AM 8:18
REG. OF DEEDS
Lucy Bond

9736

Register of Deeds Stamp & File Number

	A	B	C	D	E	F	G	H	I	J	K	L	M
1													
2	6		5		4		3		2		1		
3													
4	7		8		9		10		11		12		
5													
6	18		17		16		15		14		13		
7													
8	19		20		21		22		23		24		
9													
10	30		29		28		27		26		25		
11													
12	31		32		33		34		35		36		
13													

I, Kirk Breitels, in a field survey on Mar. 13, 1997 do hereby state that under requirements of P.A. 74, Michigan P.A. of 1970, the corner points mentioned in lines 1 and 2 above were in conformance with regulations and rules therefore as required in the current manual of survey instructions of the United States Department of the Interior, Bureau of Land Management or by a decree of a Court of Law and/or that the corner points mentioned in lines 3, 4 and 5 above were in conformance with the rules of the Michigan Board of Land Surveyors or by a Decree of a Court of Law; established, re-established, monumented, recovered, found as expressed below:

NOTE: Not more than 2 corners, all in the same town and range, may be recorded on this certificate.

A. Description of original monument and accessories and/or subsequent restoration:

Date	Monument	Accessories	Restoration
E-13 1830	GLO	Mullett	Set Post
1981	LCRC #1838	Bonnema	Set Capped Iron
1982	LCRC #2850	Jonker	Set Kent County Monument
1990	LCRC #5366	Starr	Kent County Monument

The position of this corner was previously approved by the Kent County Remonumentation Peer Group, monumented by Robert J. Jonker on 5/17/82 and was recorded per LCRC #2850

B. Description of corner evidence found and/or method applied in restoring or reestablishing corner:


E-13 Found standard Kent Co. Mon. (Harrison) per witnesses from above LCRC as set by Robert J. Jonker in place of the Capped Iron he found. Said Iron checks LCRC #1838.

Monument	Angle	Distance	Monument	Angle	Distance
LCRC #2850	N90°W	55.75'	Nail & tag 20" Maple	N90°W	55.67'
Remon. tag 20" Maple	S25°W	46.86'	Nail & tag 16" Maple cl.	S25°W	46.83'
Remon. tag 16" Maple cl.	S55°E	73.03'	Nail & tag 12" Ash	S55°E	73.00'
Remon. tag 12" Ash	N70°E	65.03'	Nail & tag 12" Maple	N70°E	65.01'
Remon. tag 12" Maple	N35°E	53.10'	Nail & tag 10" Ash	N35°E	53.02'
Remon. tag 10" Ash	East	11.22'	Iron-NE cor. Sec. 4-5-9 East	East	11.22'

The selected location is accepted by me and is generally accepted by professional surveyors as the best available evidence of the position of the original corner.

C. Description of monument for corner and accessories established to perpetuate locating the position of the corner:

Monument	Angle	Distance
E-13 Standard Kent County Monument	N90°W	55.67'
Nail & KC Remon. tag S. side 24" Maple	S25°W	46.83'
Nail & KC Remon. tag W. side 16" Maple clump	N70°E	65.08'
Nail & KC Remon. tag N. side 18" Maple	N35°E	53.10'
Nail & KC Remon. tag NW side 12" Ash	East	11.33'
Rerod at NE cor. Sec. 4, T4N, R9W		
C/L N-S grav. rd. is 12' East		
C/L grav. rd. to E. is 12' South		

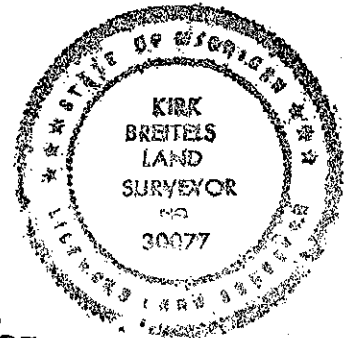

Signed by *Kirk Breitels*
Surveyor's Michigan License No. 30077

Date 3/27/97

P.A. 345 1990 KENT COUNTY
PEER APPROVED 3/27/97
CHAIRMAN *Harrison*