

**SURVEY & REMONUMENTATION**

**KENT COUNTY REMONUMENTATION**

MAR 03 1998

**LAND CORNER RECORDATION CERTIFICATE**  
Filing Requirement of Act 74, Mich. P.A. 1970

For corners in **SECTION**  
**KENT COUNTY**

Located In:	Corner Code #
T 5N R 9W	F-1
T R	
T R	
T R	
T R	
S T R	
S T R	
S T R	
S T R	

- Public Land Survey
- Property Controlling in Section
- Miscellaneous Property in Sec.

STATE OF MICHIGAN  
COUNTY OF KENT  
RECEIVED FOR RECORD  
97 OCT 14 AM 10:01  
REG. OF DEEDS  
*Paul J. Bond*

**10022**  
Register of Deeds Stamp & File Number

- Lot No. \_\_\_\_\_, Recorded Plat \_\_\_\_\_
- Private Claims \_\_\_\_\_

I, Kirk Breitels, in a field survey on June 5, 1997 do hereby state that under requirements of P.A. 74, Michigan P.A. of 1970, the corner points mentioned in lines 1 and 2 above were in conformance with regulations and rules therefore as required in the current manual of survey instructions of the United States Department of the Interior, Bureau of Land Management or by a decree of a Court of Law and /or that the corner points mentioned in lines 3, 4 and 5 above were in conformance with the rules of the Michigan Board of Land Surveyors or by a Decree of a Court of Law, established, re-established, monumented, recovered, found as expressed below:

	A	B	C	D	E	F	G	H	I	J	K	L	M
1													
2	6		5		4		3		2		1		
3													
4	7		8		9		10		11		12		
5													
6	18		17		16		15		14		13		
7													
8	19		20		21		22		23		24		
9													
10	30		29		28		27		26		25		
11													
12	31		32		33		34		35		36		
13													

NOTE: Not more than 2 corners, all in the same town and range, may be recorded on this certificate.

**A. Description of original monument and accessories and/or subsequent restoration:**

- F-1 1830---GLO---Mullett---Not Set  
---Kent Co. Wit.---Iron  
Iron (Lowell cor.) West 73.4' NW cor. hse SE 114.6'  
NE cor. church SW 108.3' SE cor. hse. NW 137.75'
- 1973---LCRC #620---Spicer---"T" Iron - "0.785' to N. Sec. line"  
C/L CP/MBT Pole N10°E 27.80' 30" Maple S20°E 42.42' 36" Oak S40°W 46.07'
- 1973---Survey---VanKooten---3/4" Iron  
PK in 30" Maple SSE 43.13' NE cor. church fnd. SW 108.61'
- 1987---LCRC #4553---Brintnall---1" Solid Iron SW 65.56' PP  
SSE 42.44' 24" Maple SE 53.85' PP N 27.75' PP W 73.61' S 1/4 Sec. 33
- 1989---Survey---Nederveld---1" Rod  
SE 53.85' PK in PP N 27.75' PK in PP SW 65.56' PK in PP


**B. Description of corner evidence found and/or method applied in restoring or reestablishing corner:**

- F-1 Found 1" Solid Iron 0.04' North of Twp. Line per following witnesses:  
Kent Co. Mon. (F-13, Lowell Twp.) West 73.60'  
NE corner church foundation SW 108.04'  
SE corner house (siding) WNW 138.10'  
C/L 42" Oak SW 47'  
Fd. Bt. spike E. side 27" Maple SSE 42.44'  
Fd. PK Nail W. side P. Pole NNE 27.80'  
Fd. PK Nail E. side P. Pole WSW 65.56'

The 1" Solid Iron is accepted by me and is generally accepted by professional surveyors as the best available evidence of the corner.

**C. Description of monument for corner and accessories established to perpetuate locating the position of the corner:**

- F-1 Set Standard Kent Co. Monument (Harrison) in place of the 1" Solid Iron  
Set Nail & KC Remon. tag W. side P. Pole N05°E 27.81'  
Set Nail & KC Remon. tag W. side 27" Maple S25°E 42.33'  
Set Nail & KC Remon. tag E. side 42" Oak S35°W 47.18'  
Set Nail & KC Remon. tag S. side 42" Oak S70°W 112.80'  
Set Nail & KC Remon. tag S. side Lt. Pole N60°W 94.17'  
Kent Co. Mon. (F-13, T6N, R9W) West 73.60'

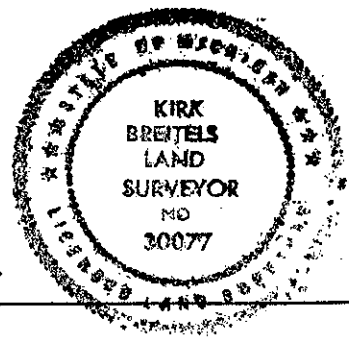

Signed by *Kirk Breitels*  
Surveyor's Michigan License No. 30077

Date 8/28/97

P.A. 345 1990 KENT COUNTY  
PEER APPROVED 7/29/97  
CHAIRMAN *Harry Kube*