

SURVEY & REMONUMENTATION

MAR 03 1998

KENT COUNTY REMONUMENTATION

LAND CORNER RECORDATION CERTIFICATE
Filing Requirement of Act 74, Mich. P.A. 1970

SECTION

For corners in
KENT COUNTY

Located In:

Corner Code #

1. Public Land Survey

T 5N R 9W F-3
T R
T R
T R

2. Property Controlling in Section

S T R
S T R
S T R
S T R

3. Miscellaneous Property in Sec.

4. Lot No. _____, Recorded Plat _____

5. Private Claims _____

Kirk Breitels

Jan. 24 19 97

in a field survey on _____ do hereby state that under requirements of P.A. 74, Michigan P.A. of 1970, the corner points mentioned in lines 1 and 2 above were in conformance with regulations and rules therefore as required in the current manual of survey instructions of the United States Department of the Interior, Bureau of Land Management or by a decree of a Court of Law and/or that the corner points mentioned in lines 3, 4 and 5 above were in conformance with the rules of the Michigan Board of Land Surveyors or by a Decree of a Court of Law, established, re-established, monumented, recovered, found as expressed below.

NOTE: Not more than 2 corners, all in the same town and range, may be recorded on this certificate.

A. Description of original monument and accessories and/or subsequent restoration:

F-3	1830	GLO	Mullett	Set Post
		Kent Co. Wit.		Iron
1961		Williams & Works		Pointed Stone
1975		LCRC #1005	Nederveid	Pointed Stone
1980		LCRC #1511	Merdzinski	Set Kent County Monument
1990		LCRC #5367	Starr	Kent County Monument

The position of this corner was previously approved by the Kent County Remonumentation Peer Group, monumented by John A. Merdzinski on 12/11/80 and was recorded per LCRC #1511

B. Description of corner evidence found and/or method applied in restoring or reestablishing corner:

F-3 Found standard Kent Co. Mon. (Harrison) per witnesses from above LCRC as set by John A. Merdzinski in place of the Pointed Stone he found over old wood stake. Said Pointed Stone checks with Williams & Works information and LCRC #1005.
LCRC #1511 Nail/tag 10" Oak N40°E 20.07' Nail/tag 12" Oak N40°E 20.26'
Nail & tag 12" Oak N70°W 40.19' Nail & tag 14" Oak N70°W 40.21'
Nail & tag Group 10" Maples S10°W 45.71' Nail & tag 12"-14" Maples S10°W 45.72'
Nail & tag 26" Oak S25°E 51.77' Nail & tag 28" Oak S25°E 51.80'
Nail & tag 14" Oak S50°W 56.76' Nail & tag 14" Oak S60°W 56.47'
Nail & tag 14" Maple S50°E 55.78' Nail & tag 14" Maple S50°E 55.82'

The selected location is accepted by me and is generally accepted by professional surveyors as the best available evidence of the position of the original corner.

C. Description of monument for corner and accessories established to perpetuate locating the position of the corner:

F-3	Standard Kent County Monument	N40°E 20.26'
	Nail & KC Remon. tag SE side 14" Oak	N70°W 40.24'
	Nail & KC Remon. tag N. side 20" Oak	S10°W 45.72'
	Nail & KC Remon. tag W. side group 6"-24" Maples	S25°E 51.80'
	Nail & KC Remon. tag W. side 36" Oak	S60°W 56.44'
	Nail & KC Remon. tag S. side 16" Oak	S50°E 55.82'
	Nail & KC Remon. tag W. side 18" Maple	
	On tree row North and West ±	


REG. OF DEEDS

97 APR 29 AM 8:18

STATE OF MICHIGAN
COUNTY OF KENT
RECEIVED FOR RECORD

9737

Register of Deeds Stamp & File Number

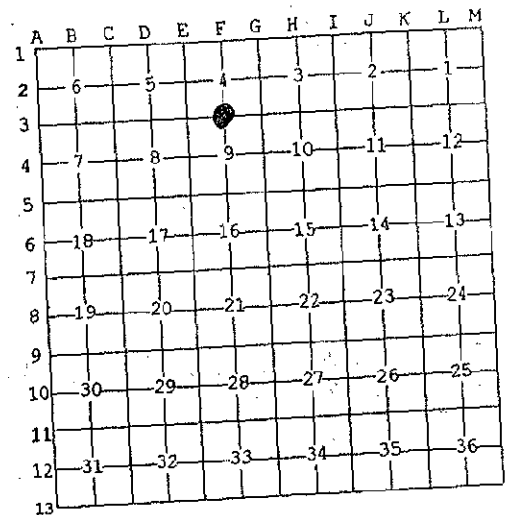

Signed by

Kirk Breitels

30077

Surveyor's Michigan License No.

P.A. 345 1990 KENT COUNTY

PEER APPROVED 3/27/97

CHAIRMAN *Harry Stuber*

Date

3/27/97

