

SURVEY & REMONUMENTATION

APR 27 1995

KENT COUNTY REMONUMENTATION

STATE OF MICHIGAN
COUNTY OF KENT
RECEIVED FOR RECORD

COMMISSION

LAND CORNER RECORDATION CERTIFICATE
Filing Requirement of Act 74, Mich. P.A. 1970

94 OCT 13 AM 9:33

For corners in
KENT COUNTY
(County)

Located In: BOWNE TWP. Corner Code #

- 1. Public Land Survey T 5N R 9W
- T _____ R _____
- T _____ R _____
- T _____ R _____
- 2. Property Controlling S _____ T _____ R _____
- in Section S _____ T _____ R _____
- 3. Miscellaneous S _____ T _____ R _____
- Property in Sec. S _____ T _____ R _____

F-4 C 1/4 cor.
Sec. 9

Log 1

Tim J. Bond
REG. OF DEEDS

7139

Register of Deeds Stamp & File Number

- 4. Lot No. _____, Recorded Plat _____
- 5. Private Claims _____

	A	B	C	D	E	F	G	H	I	J	K	L	M
2	6		5		4		3		2				
3													
4	7		8		9		10		11		12		
5													
6	13		17		16		15		14		13		
7													
8	19		20		21		22		23		24		
9													
10	30		29		28		27		26		25		
11													
12	31		32		33		34		35		36		
13													

I, William R. Byl, in a field survey on Aug. 9, 1994, do hereby certify that under requirements of P.A. 74, Michigan P.A. of 1970, the corner points mentioned in lines 1 and 2 above were in conformance with regulations and rules therefore as required in the current manual of survey instructions of the United States Department of the Interior, Bureau of Land Management or by a decree of a Court of Law and/or that the corner points mentioned in lines 3, 4 and 5 above were in conformance with the rules of the Michigan Board of Land Surveyors or by a Decree of a Court of Law; established, re-established, monumented, re-monumented, recovered, found as expressed below:

NOTE: Not more than 4 corners, all in the same town and range, may be recorded on this certificate.

A. Description of original monument and accessories and/or subsequent restoration:

- F-4 Steel bar & cap #23502 set at intersection of 1/4 lines (LCRC #3514, Sept. 21, 1983)
- Nail S. side 16" Cherry ESE 10.33'
- Nail N. side 16" Cherry ENE 17.45'
- Nail E. side 12" Cherry NNE 43.75'
- Tron N 39.62'
- New E-W fence N. 1'; Old E-W fence S. 1.5'; Fence North is E. 9'
- Position of C 1/4 cor. (never set) also used in surveys by Medema & VanKooten, 1975 and Glaza & Assoc., 1977. G.L.O. did not set.


B. Description of corner evidence found and/or method applied in restoring or reestablishing corner:

- F-4 Found steel bar & cap #23502
- C/L 24" Cherry ESE 10'
- C/L 20" Cherry ENE 17'
- C/L 24" Cherry NNE 44'
- E-W fences S. 1' & N. 1.5'

P.A. 345 1990 KENT COUNTY
PEER APPROVED 9/22/94
CHAIRMAN *Harold Wheeler*

C. Description of monument for corner and accessories established to perpetuate locating the position of the corner:

- F-4 Replaced steel bar & cap #23502 with Standard Kent County Monument
- Set Nail & KC Remon. tag E. side 24" Cherry N30°E 43.97'
- Set Nail & KC Remon. tag N. side 20" Cherry N75°E 17.07'
- Set Nail & KC Remon. tag S. side 24" Cherry S70°E 10.18'
- Set Nail & KC Remon. tag NE side Power Pole N40°W 28.98'
- Set Nail & KC Remon. tag NW side 6" Ash S55°W 63.77'
- Distances & bearings (assumed) to: E 1/4 cor. S 89°24'56" E 2620.73'
- W 1/4 cor. N 89°24'56" W 2610.26'
- S 1/4 cor. S 00°08'49" E 2632.45'
- N 1/4 cor. N 00°08'49" W 2637.32'

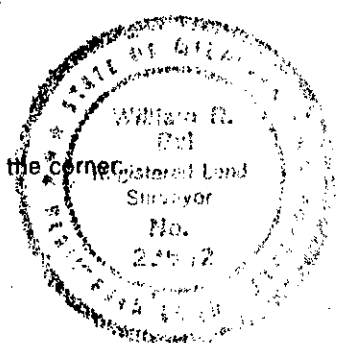

Signed by *William R. Byl*
Surveyor's Michigan License No. 23502

Date 09.27.94