

SURVEY & REMONUMENTATION

MAR 03 1998

KENT COUNTY REMONUMENTATION

SECTION LAND CORNER RECORDATION CERTIFICATE
Filing Requirement of Act 74, Mich. P.A. 1970

For corners in
KENT COUNTY

Located In: Corner Code #

1. Public Land Survey

T 5N R 9W
T R
T R
T R
S T R
S T R
S T R
S T R

F-4

Leg #2

2. Property Controlling in Section

3. Miscellaneous Property in Sec.

4. Lot No. _____, Recorded Plat _____
5. Private Claims _____

STATE OF MICHIGAN
COUNTY OF KENT
RECEIVED FOR RECORD
97 NOV 13 PM 1:00
REG. OF DEEDS
[Signature]
10264
Register of Deeds Stamp & File Number

I, Kirk Breitels, in a field survey on Aug. 11, 1997 do hereby state that under requirements of P.A. 74, Michigan P.A. of 1970, the corner points mentioned in lines 1 and 2 above were in conformance with regulations and rules therefore as required in the current manual of survey instructions of the United States Department of the Interior, Bureau of Land Management or by a decree of a Court of Law and/or that the corner points mentioned in lines 3, 4 and 5 above were in conformance with the rules of the Michigan Board of Land Surveyors or by a Decree of a Court of Law, established, re-established, monumented, recovered, found as expressed below:

NOTE: Not more than 2 corners, all in the same town and range, may be recorded on this certificate.

1	A	B	C	D	E	F	G	H	I	J	K	L	M
2		6		5		4		3		2		1	
3													
4		7		8		9		10		11		12	
5													
6		18		17		16		15		14		13	
7													
8		19		20		21		22		23		24	
9													
10		30		29		28		27		26		25	
11													
12		31		32		33		34		35		36	
13													

A. Description of original monument and accessories and/or subsequent restoration:

- F-4 1975---Survey Notes---MVK---Computed Intersection of 1/4 lines
- 1978---Surveys---Ed Glaza---Computed Intersection of 1/4 lines
- 1983---LCRC #3514---Byl---Set Rerod at Intersection of 1/4 lines
- 1994---Survey---Koerber---Rerod & Cap #23502 (Byl)
- 1994---LCRC #7139---Byl---Set Kent Co. Mon. in place of Rerod (LCRC #3514)

The position of this corner was previously approved by the Kent County Remonumentation Peer Group, monumented by William Byl on 9-27-94 and recorded per LCRC #7139.

B. Description of corner evidence found and/or method applied in restoring or reestablishing corner:

F-4 Found Kent County Monument per witnesses of LCRC #7139, however the Kent County Monument is 3.7' E. and 0.3' N. of Intersection of 1/4 lines. Upon review of survey notes and sketches of survey performed by William Byl in 1983, an error in setting the Rerod at the Center of Section was discovered. However, the 1/4 Section line computations fit Intersection of 1/4 lines. Based on the intent of William Byl to set the corner at the Intersection of 1/4 lines as well as surveys by MVK and Ed Glaza, I recommend moving the Kent County Monument to the correct location. The Intersection of 1/4 lines is accepted by me and is generally accepted by professional surveyors as the best available evidence of the corner.


C. Description of monument for corner and accessories established to perpetuate locating the position of the corner:

- F-4 Set Kent County Monument at Intersection of 1/4 lines - removed incorrect monument
- Set Nail & KC Remon. tag E. side 26" Cherry N35°E 46.16'
- Set Nail & KC Remon. tag N. side 22" Cherry N75°E 20.64'
- Set Nail & KC Remon. tag S. side 26" Cherry S70°E 13.56'
- Set Nail & KC Remon. tag NE side P. Pole N35°W 27.12'
- Set Nail & KC Remon. tag NW side 8" Cherry S50°W 60.69'
- E-W fence is 1'± North

P.A. 345 1990 KENT COUNTY

PEER APPROVED 9/27/97

CHAIRMAN [Signature]

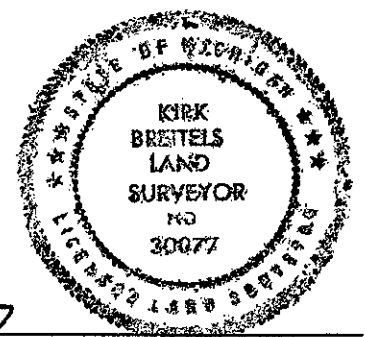

Signed by [Signature]
Surveyor's Michigan License No. 30077

Date 10/30/97