

SURVEY & REMONUMENTATION

MAR 03 1998

KENT COUNTY REMONUMENTATION

LAND CORNER RECORDATION CERTIFICATE
Filing Requirement of Act 74, Mich. P.A. 1970

For corners in **SECTION**
KENT COUNTY
(County)

Located In:	Corner Code #
T 5N R 9W	F-7
T R	
T R	
T R	
S T R	
S T R	
S T R	
S T R	

1. Public Land Survey

2. Property Controlling in Section

3. Miscellaneous Property in Sec.

4. Lot No. _____, Recorded Plat _____
5. Private Claims _____

STATE OF MICHIGAN
COUNTY OF KENT
RECEIVED FOR RECORD
97 APR 29 AM 8:18
REG. OF DEEDS
Lucy Spindel

9739

Register of Deeds Stamp & File Number

	A	B	C	D	E	F	G	H	I	J	K	L	M
1													
2	6		5		4		3		2		1		
3													
4	7		8		9		10		11		12		
5													
6	18		17		16		15		14		13		
7													
8	19		20		21		22		23		24		
9													
10	30		29		28		27		26		25		
11													
12	31		32		33		34		35		36		
13													

I, Kirk Breitels, in a field survey on Jan. 17, 1997 do hereby state that under requirements of P.A. 74, Michigan P.A. of 1970, the corner points mentioned in lines 1 and 2 above were in conformance with regulations and rules therefore as required in the current manual of survey instructions of the United States Department of the Interior, Bureau of Land Management or by a decree of a Court of Law and/or that the corner points mentioned in lines 3, 4 and 5 above were in conformance with the rules of the Michigan Board of Land Surveyors or by a Decree of a Court of Law; established, re-established, monumented, recovered, found as expressed below:

NOTE: Not more than 2 corners, all in the same town and range, may be recorded on this certificate.

A. Description of original monument and accessories and/or subsequent restoration:

F-7	1830	GLO	Mullett	Set Post
	1975	LCRC #845	Nederveld	1/2" Iron in Mon. Box
	1981	LCRC #2235	Jonker	Set Kent County Monument in Mon. Box
	1990	LCRC #5369	Starr	Kent County Monument in Mon. Box

The position of this corner was previously approved by the Kent County Remonumentation Peer Group, monumented by Robert J. Jonker on 10/30/81 and was recorded per LCRC #2235

B. Description of corner evidence found and/or method applied in restoring or reestablishing corner:


F-7 Found standard Kent Co. Mon. (Harrison) per witnesses from above LCRC as set by Robert J. Jonker in place of the 1/2" Iron he found over a Stone in a Mon. Box. Said checks with LCRC #845.

LCRC #2235	LCRC #5369
Remon. tag P. Pole S01°W 54.13'	Remon. tag P. Pole S01°W 54.13'
Remon. tag 9" Elm S52°E 50.12'	Nail & tag 12" Elm S52°E 50.15'
Face steel fc. post N01°E 35.40'	Face steel fence post N01°E 35.40'
Iron N47°W 51.96'	Nail & tag 10" Tree S80°W 92.57'

The selected location is accepted by me and is generally accepted by professional surveyors as the best available evidence of the position of the original corner.

C. Description of monument for corner and accessories established to perpetuate locating the position of the corner:

F-7 Standard Kent County Monument in Mon. Box	
Nail & KC Remon. tag SW side 16" Elm	S52°E 50.11'
Face of steel fence post	N01°E 35.40'
Nail & KC Remon. tag W. side 14" Elm	S35°E 37.96'
Nail & KC Remon. tag W. side 22" Elm	S05°W 33.54'
In line N-S fence and tree lines	
C/L E-W blacktop road is North 2'±	

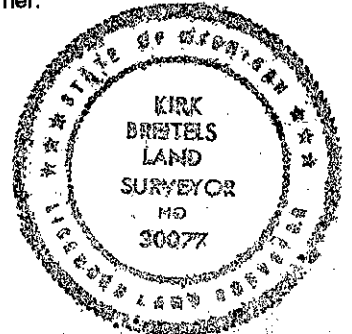

Signed by *Kirk Breitels*
Surveyor's Michigan License No. 30077

Date 3/27/97

P.A. 345 1990 KENT COUNTY
REER APPROVED 3/27/97
CHAIRMAN *Harry Kubers*