

SURVEY & REMONUMENTATION

MAR 03 1998

KENT COUNTY REMONUMENTATION

LAND CORNER RECORDATION CERTIFICATE
Filing Requirement of Act 74, Mich. P.A. 1970

SECTION

For corners in

KENT COUNTY

(County)

Located In:

Corner Code #

- | | | |
|------------------------------------|---------------------------|-------|
| 1. Public Land Survey | T <u>5</u> N R <u>9</u> W | F-11 |
| | T ___ R ___ | _____ |
| | T ___ R ___ | _____ |
| | T ___ R ___ | _____ |
| 2. Property Controlling in Section | S ___ T ___ R ___ | _____ |
| | S ___ T ___ R ___ | _____ |
| 3. Miscellaneous Property in Sec. | S ___ T ___ R ___ | _____ |
| | S ___ T ___ R ___ | _____ |

STATE OF MICHIGAN
COUNTY OF KENT
RECEIVED FOR RECORD

97 JUN -3 AM 8:12

REG. OF DEEDS

Lucy Bond

10008

Register of Deeds Stamp & File Number

4. Lot No. _____, Recorded Plat _____
5. Private Claims _____

I, Kirk Breitels, in a field survey on Apr. 14, 1997 do hereby state that under requirements of P.A. 74, Michigan P.A. of 1970, the corner points mentioned in lines 1 and 2 above were in conformance with regulations and rules therefore as required in the current manual of survey instructions of the United States Department of the Interior, Bureau of Land Management or by a decree of a Court of Law and /or that the corner points mentioned in lines 3, 4 and 5 above were in conformance with the rules of the Michigan Board of Land Surveyors or by a Decree of a Court of Law; established, re-established, monumented, recovered, found as expressed below:

NOTE: Not more than 2 corners, all in the same town and range, may be recorded on this certificate.

A	B	C	D	E	F	G	H	I	J	K	L	M
1												
2	6	5	4	3	2	1						
3												
4	7	8	9	10	11	12						
5												
6	18	17	16	15	14	13						
7												
8	19	20	21	22	23	24						
9												
10	30	29	28	27	26	25						
11												
12	31	32	33	34	35	36						
13												

A. Description of original monument and accessories and/or subsequent restoration:

F-11	1830	GLO	Mullett	Set Post
	1944	Kent Co. Wit.		Iron
	1977	LCRC #1091	VanKooten	1" Iron in Mon. Box
	1981	LCRC #2236	Jonker	Set Kent County Monument in Mon. Box
	1990	LCRC #5371	Starr	Kent County Monument

The position of this corner was previously approved by the Kent County Remonumentation Peer Group, monumented by Robert J. Jonker on 11/6/81 and was recorded per LCRC #2236.

B. Description of corner evidence found and/or method applied in restoring or reestablishing corner:


F-11 Found standard Kent Co. Mon. (Harrison) per witnesses from above LCRC as set by Robert J. Jonker in place of the 1" Iron in a Conc. Mon. he found inside a Mon. Box. Said Iron checks with Kent Co. Wit. and LCRC #1091.

<u>LCRC #2236</u>		<u>LCRC #5371</u>	
Remon. tag 30" Cherry	N65°W 68.34'	Nail & tag 32" Cherry	N65°W 68.33'
Remon. tag 8" Elm	S59°W 52.85'	Nail & tag 12" Elm	S60°W 52.91'
Remon. tag 9" Ironwood	S04°E 30.88'	Nail & tag 10" Ironwood	S02°E 30.66'
Remon. tag 32" Maple	S69°E 82.90'	Nail & tag 36" Maple	S68°E 82.74'
Remon. tag 18" Elm	N59°E 47.77'	Nail & tag 18" Elm	N60°E 47.76'

The selected location is accepted by me and is generally accepted by professional surveyors as the best available evidence of the position of the original corner.

C. Description of monument for corner and accessories established to perpetuate locating the position of the corner:

- F-11 Standard Kent County Monument
- Nail & KC Remon. tag SW side 36" Cherry N65°W 68.33'
 - Nail & KC Remon. tag NW side 12" dead Elm S60°W 52.91'
 - Nail & KC Remon. tag E. side 16" Ironwood S02°E 30.62'
 - Nail & KC Remon. tag N. side 36" Maple S68°E 82.70'
 - Nail & KC Remon. tag S. side 24" Elm N60°E 47.76'
- On C/L E-W bit. road & on tree line to N.
Tree and fence line to S. is 8'± East

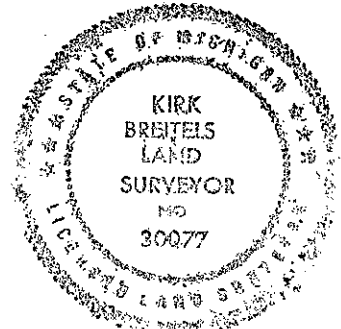

Signed by *Kirk Breitels*
Surveyor's Michigan License No. 30077

Date 5/22/97

P.A. 345 1990 KENT COUNTY
PEER APPROVED 5/22/97
CHAIRMAN *Harry Hubert*