

SURVEY & REMONUMENTATION

MAR 03 1998

KENT COUNTY REMONUMENTATION

LAND CORNER RECORDATION CERTIFICATE
Filing Requirement of Act 74, Mich. P.A. 1970

SECTION

For corners in
KENT COUNTY

(County)

Located In:

Corner Code #

| | | | | | |
|------------------------------------|---|----|---|----|-----|
| 1. Public Land Survey | T | 5N | R | 9W | G-1 |
| | T | | R | | |
| | T | | R | | |
| | T | | R | | |
| 2. Property Controlling in Section | S | | T | R | |
| | S | | T | R | |
| 3. Miscellaneous Property in Sec. | S | | T | R | |
| | S | | T | R | |

REG. OF DEEDS

Luci Standa

97 APR 29 AM 8:18

STATE OF MICHIGAN
COUNTY OF KENT
RECEIVED FOR RECORD

9742

Register of Deeds Stamp & File Number

4. Lot No. _____, Recorded Plat _____
5. Private Claims _____

I, Kirk Breitels, in a field survey on Jan. 21 1997 do hereby state that under requirements of P.A. 74, Michigan P.A. of 1970, the corner points mentioned in lines 1 and 2 above were in conformance with regulations and rules therefore as required in the current manual of survey instructions of the United States Department of the Interior, Bureau of Land Management or by a decree of a Court of Law and/or that the corner points mentioned in lines 3, 4 and 5 above were in conformance with the rules of the Michigan Board of Land Surveyors or by a Decree of a Court of Law; established, re-established, monumented, recovered, found as expressed below:

| | | | | | | | | | | | | | |
|----|---|----|---|----|---|----|---|----|---|----|---|----|---|
| 1 | A | B | C | D | E | F | G | H | I | J | K | L | M |
| 2 | | 6 | | 5 | | 4 | | 3 | | 2 | | 1 | |
| 3 | | | | | | | | | | | | | |
| 4 | | 7 | | 8 | | 9 | | 10 | | 11 | | 12 | |
| 5 | | | | | | | | | | | | | |
| 6 | | 18 | | 17 | | 16 | | 15 | | 14 | | 13 | |
| 7 | | | | | | | | | | | | | |
| 8 | | 19 | | 20 | | 21 | | 22 | | 23 | | 24 | |
| 9 | | | | | | | | | | | | | |
| 10 | | 30 | | 29 | | 28 | | 27 | | 26 | | 25 | |
| 11 | | | | | | | | | | | | | |
| 12 | | 31 | | 32 | | 33 | | 34 | | 35 | | 36 | |
| 13 | | | | | | | | | | | | | |

NOTE: Not more than 2 corners, all in the same town and range, may be recorded on this certificate.

A. Description of original monument and accessories and/or subsequent restoration:

| | | | | |
|-----|------|---------------|----------|---------------------------------------|
| G-1 | 1830 | GLO | Mullett | Set Post |
| | 1933 | Kent Co. Wit. | | Iron & Stones |
| | 1983 | LCRC #3217 | Bonnema | 3/4" Iron |
| | 1986 | LCRC #4423 | Jonker | Set Kent County Monument on twp. line |
| | 1995 | LCRC #8222 | Breitels | Kent County Monument |

The position of this corner was previously approved by the Kent County Remonumentation Peer Group, monumented by Robert J. Jonker on 4/8/86 and was recorded per LCRC #4423.

B. Description of corner evidence found and/or method applied in restoring or reestablishing corner:


G-1 Found standard Kent Co. Mon. (Harrison) per witnesses from above LCRC as set by Robert J. Jonker on Twp. line in place of the 3/4" Round Iron he found. Said Round Iron checks with LCRC #3217. All Kent Co. wit. are gone.

| | | | | | | | |
|-------------------|----------------------------|-------|--------|-------------------|----------------------------|-------|--------|
| <u>LCRC #4423</u> | Kent Co. Mon. | West | 65.96' | <u>LCRC #8222</u> | Kent Co. Mon. (G-13,6-9) | West | 66.00' |
| | Remon. tag SE side P. Pole | N30°E | 26.14' | | Nail & tag P. Pole | N30°E | 26.14' |
| | NE cor. 2' x 5' conc. slab | S15°E | 41.12' | | NE cor. 2' x 5' conc. slab | S15°E | 41.25' |
| | C/L top conc. culvert | N85°E | 93.48' | | C/L E. end top conc. culv. | N85°E | 93.48' |

The selected location is accepted by me and is generally accepted by professional surveyors as the best available evidence of the position of the original corner.

C. Description of monument for corner and accessories established to perpetuate locating the position of the corner:

| | | | |
|--------------------------------------|-------|--------|--|
| G-1 Standard Kent County Monument | | | |
| Kent Co. Mon. (G-13, T6N, R9W) | West | 66.00' | |
| Nail & KC Remon. tag SE side P. Pole | N30°E | 26.14' | |
| NE corner 2' x 5' conc. slab | S15°E | 41.25' | |
| C/L E. end top conc. culvert | N85°E | 93.48' | |

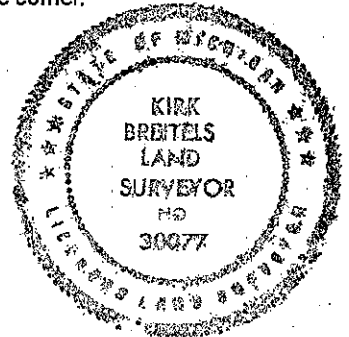

Signed by Kirk Breitels
Surveyor's Michigan License No. 30077

Date 3/27/97

P.A. 345 1990 KENT COUNTY
PEER APPROVED 3/27/97
CHAIRMAN Harry Huber