

MAR 03 1998

SECTION

KENT COUNTY REMONUMENTATION

LAND CORNER RECORDATION CERTIFICATE
Filing Requirement of Act 74, Mich. P.A. 1970

For corners in

KENT COUNTY

(County)

Located In:

Corner Code #

1. Public Land Survey	T	5N	R	9W	G-2
	T		R		
	T		R		
	T		R		
2. Property Controlling in Section	S		T	R	
	S		T	R	
3. Miscellaneous Property in Sec.	S		T	R	
	S		T	R	

STATE OF MICHIGAN
COUNTY OF KENT
RECEIVED FOR RECORD

97 JUN -3 AM 8:12

REG. OF DEEDS

Eric S. Smith

10009

Register of Deeds Stamp & File Number

4. Lot No. _____, Recorded Plat _____
5. Private Claims _____

I, Kirk Breitels, in a field survey on Apr. 15 1997 do hereby state that under requirements of P.A. 74, Michigan P.A. of 1970, the corner points mentioned in lines 1 and 2 above were in conformance with regulations and rules therefore as required in the current manual of survey instructions of the United States Department of the Interior, Bureau of Land Management or by a decree of a Court of Law and/or that the corner points mentioned in lines 3, 4 and 5 above were in conformance with the rules of the Michigan Board of Land Surveyors or by a Decree of a Court of Law; established, re-established, monumented, recovered, found as expressed below:

NOTE: Not more than 2 corners, all in the same town and range, may be recorded on this certificate.

	A	B	C	D	E	F	G	H	I	J	K	L	M
1													
2	6		5			4	●	3		2			1
3													
4	7		8			9		10		11			12
5													
6	18		17			16		15		14			13
7													
8	19		20			21		22		23			24
9													
10	30		29			28		27		26			25
11													
12	31		32			33		34		35			36
13													

A. Description of original monument and accessories and/or subsequent restoration:

G-2	1830	GLO	Mullett	Set Post
		Kent Co. Wit.		Mon. Box
	1973	LCRC #406	VanKooten	1/2" Rod in Mon. Box
	1971	LCRC #2237	Jonker	Set Kent County Monument in Mon. Box
	1990	LCRC #5373	Starr	Kent County Monument

The position of this corner was previously approved by the Kent County Remonumentation Peer Group, monumented by Robert J. Jonker on 11/6/81 and was recorded per LCRC #2237

B. Description of corner evidence found and/or method applied in restoring or reestablishing corner:


G-2 Found standard Kent Co. Mon. (Harrison) per witnesses from above LCRC as set by Robert J. Jonker in place of the 1/2" Rerod he found inside a Mon. Box. Said Rerod checks with Kent Co. Wit. and LCRC #406.

<u>LCRC #2237</u>		<u>LCRC #5373</u>		
Remon. tag P. Pole	N35°E	56.77'	Nail & tag P. Pole	S24°W 71.53'
Remon. tag P. Pole	S35°E	82.62'	Nail & tag P. Pole	N35°E 56.78'
Remon. tag T. Pole	N48°W	40.37'	Nail & tag P. Pole	S35°E 82.63'
NE cor. brk. bldg.	S50°W	124.47'	Nail & tag T. Pole	N48°W 40.32'
			NE cor. brk. bldg.	S50°W 124.47'

The selected location is accepted by me and is generally accepted by professional surveyors as the best available evidence of the position of the original corner.

C. Description of monument for corner and accessories established to perpetuate locating the position of the corner:

G-2	Standard Kent County Monument			
	Nail & KC Remon. tag NW side P. Pole	S24°W	71.59'	
	Nail & KC Remon. tag NW side P. Pole	N35°E	56.78'	
	Nail & KC Remon. tag SW side P. Pole	S35°E	82.58'	
	Nail & KC Remon. tag SW side T. Pole	N48°W	40.32'	
	NE corner brick building	S50°W	124.47'	
	C/L N-S blacktop road is East 2.7'±			
	C/L E-W blacktop road is South 9.5'±			

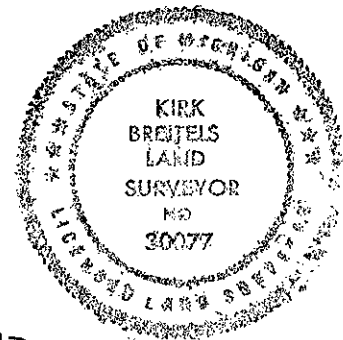

Signed by *Kirk Breitels*
Surveyor's Michigan License No. 30077

Date 5/22/97

P.A. 345 1990 KENT COUNTY
PEER APPROVED 5/22/97
CHAIRMAN *Harry Hubert*