

SURVEY & REMONUMENTATION

MAR 03 1998

KENT COUNTY REMONUMENTATION


LAND CORNER RECORDATION CERTIFICATE
Filing Requirement of Act 74, Mich. P.A. 1970

SECTION

For corners in
KENT COUNTY
(County)

Located In:	Corner Code #
T 5N R 9W	G-3
T R	
T R	
T R	
S T R	
S T R	
S T R	
S T R	

- 1. Public Land Survey
- 2. Property Controlling in Section
- 3. Miscellaneous Property in Sec.

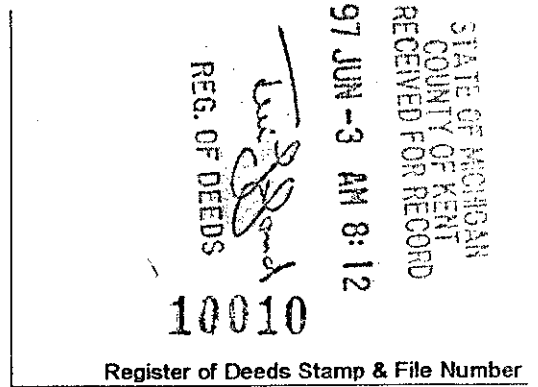

- 4. Lot No. _____, Recorded Plat _____
- 5. Private Claims _____

I, Kirk Breitels, in a field survey on Apr. 15, 1997 do hereby state that under requirements of P.A. 74, Michigan P.A. of 1970, the corner points mentioned in lines 1 and 2 above were in conformance with regulations and rules therefore as required in the current manual of survey instructions of the United States Department of the Interior, Bureau of Land Management or by a decree of a Court of Law and/or that the corner points mentioned in lines 3, 4 and 5 above were in conformance with the rules of the Michigan Board of Land Surveyors or by a Decree of a Court of Law; established, re-established, monumented, recovered, found as expressed below:

	A	B	C	D	E	F	G	H	I	J	K	L	M
1													
2	6		5		4		3		2		1		
3							●						
4	7		0		9		10		11		12		
5													
6	18		17		16		15		14		13		
7													
8	19		20		21		22		23		24		
9													
10	30		29		28		27		26		25		
11													
12	31		32		33		34		35		36		
13													

NOTE: Not more than 2 corners, all in the same town and range, may be recorded on this certificate.

A. Description of original monument and accessories and/or subsequent restoration:

G-3	1830	GLO	Mullett	Set Post
		Kent Co. Wit.		1" Iron and stone
	1980	LCRC #1336	Byl	Mon. Box
	1981	LCRC #2238	Jonker	Set Kent County Monument in Mon. Box
	1990	LCRC #5374	Starr	Kent County Monument

The position of this corner was previously approved by the Kent County Remonumentation Peer Group, monumented by Robert J. Jonker on 11/4/81 and was recorded per LCRC #2238.

B. Description of corner evidence found and/or method applied in restoring or reestablishing corner:

G-3 Found standard Kent Co. Mon. (Harrison) per witnesses from above LCRC as set by Robert J. Jonker in place of the 1" Iron he found inside a Mon. Box. Said Iron checks with Kent Co. Wit. and LCRC #1336.

LCRC #2238				LCRC #5374			
Remon. tag 32" Oak	N75°W	28.3'		Remon. tag 32" Oak	N75°W	28.26'	
Remon. tag 32" Oak	N47°W	36.6'		Remon. tag 32" Oak	N47°W	36.61'	
Remon. tag 14" Ironwood	N14°W	95.85'		Remon. tag 14" Ironwood	N14°W	95.91'	
Remon. tag 30" Maple	N20°E	142.35'		Remon. tag 30" Maple	N20°E	142.35'	


The selected location is accepted by me and is generally accepted by professional surveyors as the best available evidence of the position of the original corner.

C. Description of monument for corner and accessories established to perpetuate locating the position of the corner:

G-3 Standard Kent County Monument

Nail & KC Remon. tag S. side 34" Oak	N75°W	28.26'
Nail & KC Remon. tag S. side 34" Oak	N47°W	36.61'
Nail & KC Remon. tag E. side 16" Ironwood	N14°W	95.91'
Nail & KC Remon. tag W. side 30" Maple	N20°E	142.33'

C/L pavement is East 4.8'±
On brush and tree row to West

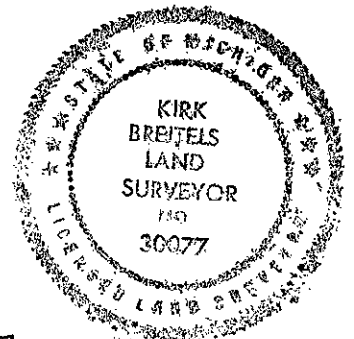

Signed by Kirk Breitels
Surveyor's Michigan License No. 30077
P.A. 345 1990 KENT COUNTY
PEER APPROVED 5/22/97
CHAIRMAN Harry Huber

Date 5/22/97