

# SURVEY & REMONUMENTATION

MAR 03 1998

KENT COUNTY REMONUMENTATION

## SECTION

### LAND CORNER RECORDATION CERTIFICATE Filing Requirement of Act 74, Mich. P.A. 1970

For corners in

KENT COUNTY

(County)

Located In:

Corner Code #

- |                                    |                         |       |       |
|------------------------------------|-------------------------|-------|-------|
| 1. Public Land Survey              | T <u>5N</u> R <u>9W</u> | G-6   |       |
|                                    | T _____ R _____         | _____ | _____ |
|                                    | T _____ R _____         | _____ | _____ |
|                                    | T _____ R _____         | _____ | _____ |
| 2. Property Controlling in Section | S _____ T _____ R _____ | _____ | _____ |
|                                    | S _____ T _____ R _____ | _____ | _____ |
| 3. Miscellaneous Property in Sec.  | S _____ T _____ R _____ | _____ | _____ |
|                                    | S _____ T _____ R _____ | _____ | _____ |

REGISTER OF DEEDS  
 RECEIVED FOR RECORD  
 97 OCT 14 AM 10:01  
 STATE OF MICHIGAN  
 COUNTY OF KENT

10023

Register of Deeds Stamp & File Number

4. Lot No. \_\_\_\_\_, Recorded Plat \_\_\_\_\_
5. Private Claims \_\_\_\_\_

I, Kirk Breitels, in a field survey on June 5, 1997 do hereby state that under requirements of P.A. 74, Michigan P.A. of 1970, the corner points mentioned in lines 1 and 2 above were in conformance with regulations and rules therefore as required in the current manual of survey instructions of the United States Department of the Interior, Bureau of Land Management or by a decree of a Court of Law and /or that the corner points mentioned in lines 3, 4 and 5 above were in conformance with the rules of the Michigan Board of Land Surveyors or by a Decree of a Court of Law; established, re-established, monumented, recovered, found as expressed below:

NOTE: Not more than 2 corners, all in the same town and range, may be recorded on this certificate.

	A	B	C	D	E	F	G	H	I	J	K	L	M
1													
2	6		5		4		3		2		1		
3													
4	7		8		9		10		11		12		
5													
6	18		17		16		15		14		13		
7													
8	19		20		21		22		23		24		
9													
10	30		29		28		27		26		25		
11													
12	31		32		33		34		35		36		
13													

**A. Description of original monument and accessories and/or subsequent restoration:**

- G-6 1830---GLO---Mullett---Not Set  
 Kent Co. Wit.---Iron & Stone  
 C/L Fc. Post W 27.6' 24" Beech SE 49.6' 8" Hickory E 54.28'  
 12" Hickory E 54.28' 12" Cherry W 88.93'  
 1977---Consumers Power Co.---Monument Box  
 Steel Fc. Post W 50.15' P. Pole E 48.60' 8" Hickory S50°E 44.12'  
 1981---LCRC #1810---Bonnema---Re-rod in Mon. Box  
 28" Walnut E 30.56' 10" Hick. SE 44.10' 8" Elm SW 73.35' Iron W 49.95'  
 1982---LCRC #3553---VanKooten---1/2" Rod in Mon. Box  
 28" Ash E 30.57' 12" Hickory SE 44.08 C/L top fc. post W 50.17'  
 C/L N-S road is 0.5' West


**B. Description of corner evidence found and/or method applied in restoring or reestablishing corner:**

- G-6 Found 1/2" Rerod in Monument Box per the following remaining witnesses:  
 C/L top of steel fence post West 50.17'  
 C/L 14" Hickory SE 44'± All Kent Co. Wit.  
 Nail in P. Pole East 48.58' are gone  
 Fd. bent rerod West 50'±  
 C/L N-S road (newer pvmt.) West 2'±  
 On fence line to West and North edge of woods East

The Rerod in the Monument Box is accepted by me and is generally accepted by professional surveyors as the best available evidence of the original corner.

**C. Description of monument for corner and accessories established to perpetuate locating the position of the corner:**

- G-6 Set Standard Kent Co. Monument (Harrison) in Monument Box in place of the Rerod  
 Set Nail & KC Remon. tag SE side 14" Hickory S50°E 44.28'  
 Set Nail & KC Remon. tag S. side P. Pole S90°E 48.58'  
 Set Nail & KC Remon. tag W. side 30" Box Elder S30°E 81.04'  
 E. face 3" steel fence post S85°W 49.92'  
 On fence line to West and N. edge woods to East  
 C/L N-S pavement is West 2'±

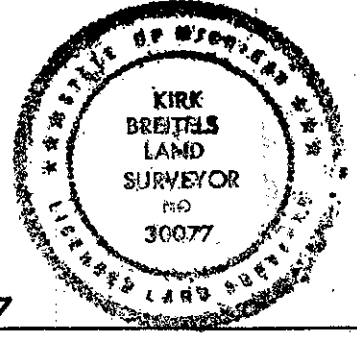

Signed by Kirk Breitels  
 Surveyor's Michigan License No. 30077

Date 8/28/97

P.A. 345 1990 KENT COUNTY  
 PEER APPROVED 6/26/97  
 CHAIRMAN Harry Hubert