

**SURVEY & REMONUMENTATION**

MAR 03 1998

KENT COUNTY REMONUMENTATION

SECTION

**LAND CORNER RECORDATION CERTIFICATE**  
Filing Requirement of Act 74, Mich. P.A. 1970

STATE OF MICHIGAN  
COUNTY OF KENT  
RECEIVED FOR RECORD  
97 NOV 13 PM 1:00  
REG. OF DEEDS  
*David Strand*

For corners in

KENT COUNTY

Located in:

Corner Code #

(County)

1. Public Land Survey

T	5N	R	9W	G-8
T		R		
T		R		
T		R		
S		T		
S		T		
S		T		
S		T		

2. Property Controlling in Section

3. Miscellaneous Property in Sec.

10266

Register of Deeds Stamp & File Number

4. Lot No. \_\_\_\_\_, Recorded Plat \_\_\_\_\_

5. Private Claims \_\_\_\_\_

I, Kirk Breitels, in a field survey on Sept. 5, 1997 do hereby state that under requirements of P.A. 74, Michigan P.A. of 1970, the corner points mentioned in lines 1 and 2 above were in conformance with regulations and rules therefore as required in the current manual of survey instructions of the United States Department of the Interior, Bureau of Land Management or by a decree of a Court of Law and/or that the corner points mentioned in lines 3, 4 and 5 above were in conformance with the rules of the Michigan Board of Land Surveyors or by a Decree of a Court of Law; established, re-established, monumented, recovered, found as expressed below:

NOTE: Not more than 2 corners, all in the same town and range, may be recorded on this certificate.

1	A	B	C	D	E	F	G	H	I	J	K	L	M
2		6		5		4		3		2		1	
3													
4		7		8		9		10		11		12	
5													
6		18		17		16		15		14		13	
7													
8		19		20		21		22		23		24	
9													
10		30		29		28		27		26		25	
11													
12		31		32		33		34		35		36	
13													

A. Description of original monument and accessories and/or subsequent restoration:

G-8 1830---GLO---Mullett---Set Post  
 ---Williams & Works---No information  
 1944---Kent Co. Wit.---Iron  
 30" Oak ENE 23.8' Fe. Post W 28.90' 26" Oak NW 67.61'  
 18" Oak NE 69.97' Cor. hse. NW 109.1' C.P. SW 44.30'  
 2627.0' North to G-7

P.A. 345 1990 KENT COUNTY  
 PEER APPROVED 5/25/97  
 CHAIRMAN Henry Thibault


B. Description of corner evidence found and/or method applied in restoring or reestablishing corner:

G-8 Found Boat Spike in Monument Box that fits remaining witnesses:  
 SW cor. hse. fnd. WNW 109.1'  
 C/L 52" Oak NW 68'  
 Meas. 2626.58' North to G-7  
 On fence line to West and fits 1/8" line occupation N & S ±  
 C/L N-S asphalt road is West 1' ±

The Boat Spike in Monument Box is accepted by me and is generally accepted by professional surveyors as the best available evidence of the original corner.

C. Description of monument for corner and accessories established to perpetuate locating the position of the corner:

G-8 Set Standard Kent Co. Monument (Harrison) in Mon. Box in place of the Boat Spike  
 Nail & KC Remon. tag E. side 52" Oak N30°W 67.90'  
 SE corner concrete porch N65°W 101.86'  
 Nail & KC Remon. tag N. side 12" Cherry N70°E 30.81'  
 Nail & KC Remon. tag E. side 18" Pine S15°E 86.90'  
 Nail & KC Remon. tag E. side Tri. 14" Hickory S50°W 36.38'

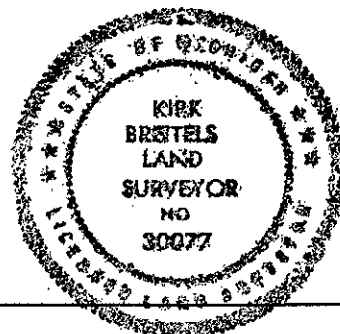

Signed by Kirk Breitels  
 Surveyor's Michigan License No. 30077

Date 10/30/97