

SURVEY & REMONUMENTATION

MAR 03 1998

KENT COUNTY REMONUMENTATION

SECTION

LAND CORNER RECORDATION CERTIFICATE
Filing Requirement of Act 74, Mich. P.A. 1970

For corners in
KENT COUNTY

Located in:

Corner Code #

1. Public Land Survey

T 5N R 9W

G-9

2. Property Controlling in Section

S

T

R

3. Miscellaneous Property in Sec.

S

T

R

4. Lot No. _____, Recorded Plat _____

5. Private Claims _____

STATE OF MICHIGAN
COUNTY OF KENT
RECEIVED FOR RECORD

97 APR 29 AM 8:18

REG. OF DEEDS

Lucy Jones

9743

Register of Deeds Stamp & File Number

I, Kirk Breitels, in a field survey on Jan. 27, 1997 do hereby state that under requirements of P.A. 74, Michigan P.A. of 1970, the corner points mentioned in lines 1 and 2 above were in conformance with regulations and rules therefore as required in the current manual of survey instructions of the United States Department of the Interior, Bureau of Land Management or by a decree of a Court of Law and/or that the corner points mentioned in lines 3, 4 and 5 above were in conformance with the rules of the Michigan Board of Land Surveyors or by a Decree of a Court of Law; established, re-established, monumented, recovered, found as expressed below:

NOTE: Not more than 2 corners, all in the same town and range, may be recorded on this certificate.

A	B	C	D	E	F	G	H	I	J	K	L	M
1												
2	6	5	4	3	2	1						
3												
4	7	8	9	10	11	12						
5												
6	18	17	16	15	14	13						
7												
8	19	20	21	22	23	24						
9												
10	30	29	28	27	26	25						
11												
12	31	32	33	34	35	36						
13												

A. Description of original monument and accessories and/or subsequent restoration:

G-9	1830	GLO	Mullett	Set Post
		Kent Co. Wit.		Iron Rod
	1973	LCRC #390	Spicer	3/4" Iron
	1981	LCRC #1626	Byl	Mon. Box
	1981	LCRC #2241	Jonker	Set Kent County Monument in Mon. Box
	1990	LCRC #5378	Starr	Kent County Monument in Mon. Box

The position of this corner was previously approved by the Kent County Remonumentation Peer Group, monumented by Robert J. Jonker on 11/6/81 and was recorded per LCRC #2241

B. Description of corner evidence found and/or method applied in restoring or reestablishing corner:

G-9 Found standard Kent Co. Mon. (Harrison) per witnesses from above LCRC as set by Robert J. Jonker in place of the 3/4" Iron he found inside a Mon. Box. Said Iron checks with Kent Co. Wit. and LCRC's #390 & #1626.


<u>LCRC #2241</u>		<u>LCRC #5378</u>	
Remon. tag curb joint	S60°W 37.81'	Remon. tag 30" Maple	N20°W 84.82'
Remon. tag 30" Maple	N20°W 84.82'	Nail & tag P. Pole	N50°E 71.83'
Remon. tag P. Pole	N50°E 72.97'	NW corner garage fnd.	S74°E 139.00'
NW corner gar. fnd.	S74°E 139.00'	NW corner frame hse.	S35°E 70.82'
On C/L "X" pavement		Nail & tag P. Pole	S50°W 53.67'

The selected location is accepted by me and is generally accepted by professional surveyors as the best available evidence of the position of the original corner.

C. Description of monument for corner and accessories established to perpetuate locating the position of the corner:

G-9 Standard Kent County Monument

Nail & KC Remon. tag NW side P. Pole	N50°E	71.86'
NW corner garage siding	S74°E	139.00'
NW corner frame house	S35°E	70.82'
Nail & KC Remon. tag NW side P. Pole	S50°W	53.57'
Nail & KC Remon. tag W. side 20" Maple	N20°W	113.88'
On C/L of blacktop pavement N-S & E-W		

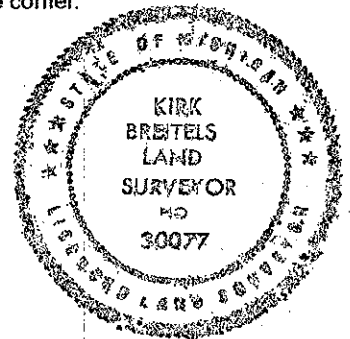

Signed by *Kirk Breitels*
Surveyor's Michigan License No. 30077

Date 3/27/97

P.A. 345 1990 KENT COUNTY
PEER APPROVED 3/27/97
CHAIRMAN *Harry Kubese*