

MAR 03 1998

SECTION

KENT COUNTY REMONUMENTATION

LAND CORNER RECORDATION CERTIFICATE
Filing Requirement of Act 74, Mich. P.A. 1970

STATE OF MICHIGAN
COUNTY OF KENT
RECEIVED FOR RECORD
97 APR 29 AM 8:18
REG. OF DEEDS
Lucy Spauld

For corners in

KENT COUNTY (County)	Located In:	Corner Code #
1. Public Land Survey	T 5N R 9W	G-10
	T R	
	T R	
	T R	
2. Property Controlling in Section	S T R	
	S T R	
3. Miscellaneous Property in Sec.	S T R	
	S T R	

9744

Register of Deeds Stamp & File Number

4. Lot No. _____, Recorded Plat _____
5. Private Claims _____

I, Kirk Breitels, in a field survey on Jan. 27, 19 97 do hereby state that under requirements of P.A. 74, Michigan P.A. of 1970, the corner points mentioned in lines 1 and 2 above were in conformance with regulations and rules therefore as required in the current manual of survey instructions of the United States Department of the Interior, Bureau of Land Management or by a decree of a Court of Law and /or that the corner points mentioned in lines 3, 4 and 5 above were in conformance with the rules of the Michigan Board of Land Surveyors or by a Decree of a Court of Law, established, re-established, monumented, recovered, found as expressed below:

NOTE: Not more than 2 corners, all in the same town and range, may be recorded on this certificate.

	A	B	C	D	E	F	G	H	I	J	K	L	M
1													
2		6		5		4		3		2		1	
3													
4		7		8		9		10		11		12	
5													
6		18		17		16		15		14		13	
7													
8		19		20		21		22		23		24	
9													
10		30		29		28		27		26		25	
11													
12		31		32		33		34		35		36	
13													

A. Description of original monument and accessories and/or subsequent restoration:

G-10	1830	GLO	Mullett	Set Post
	1973	LCRC #390	Spicer	Monument
	1981	LCRC #1626	Byl	3/8" Rod
	1981	LCRC #2242	Jonker	Set Kent County Monument
	1990	LCRC #5379	Starr	Kent County Monument

The position of this corner was previously approved by the Kent County Remonumentation Peer Group, monumented by Robert J. Jonker on 11/6/81 and was recorded per LCRC #2242

B. Description of corner evidence found and/or method applied in restoring or reestablishing corner:


G-10 Found standard Kent Co. Mon. (Harrison) per witnesses from above LCRC as set by Robert J. Jonker in place of the Concrete Monument he found. Said Concrete Monument checks with LCRC's #390 & #1626.

LCRC #2242	LCRC #5379	Face steel fc. post	S27°W 70.19'
Remon. tag P. Pole	S71°E 25.29'	Nail & tag Serv. Pole	N50°W 83.44'
Remon. tag 18" Hickory	N84°E 27.83'	Nail & tag Serv. Pole	S70°E 25.32'
Remon. tag 24" Walnut	N35°E 35.85'	Nail & tag 22" Hickory	N85°E 27.83'
Remon. tag 9" Pine	N90°W 32.00'	Nail & tag 32" Walnut	N38°E 35.83'
Face steel fence post	S25°W 70.24'	Nail & tag 10" W. Pine	N87°W 32.00'

The selected location is accepted by me and is generally accepted by professional surveyors as the best available evidence of the position of the original corner.

C. Description of monument for corner and accessories established to perpetuate locating the position of the corner:

G-10 Standard Kent County Monument			
Nail & KC Remon. tag NE side Service Pole	N50°W	83.19'	
Nail & KC Remon. tag S. side Service Pole	S70°E	25.36'	
Nail & KC Remon. tag S. side 26" Hickory	N85°E	28.03'	
Nail & KC Remon. tag SE side 32" Walnut	N38°E	35.83'	
Nail & KC Remon. tag S. side 14" White Pine	N87°W	32.00'	
Face steel fence corner post (1' above grd.)	S27°W	70.29'	
C/L N-S bit. road is 2' ± West			

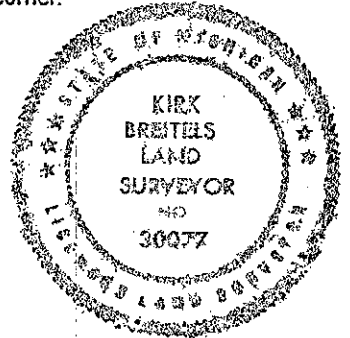

Signed by *Kirk Breitels*
Surveyor's Michigan License No. 30077

Date 3/27/97

P.A. 345 1990 KENT COUNTY
PEER APPROVED 3/27/97
CHAIRMAN *Frank Kubers*