

SURVEY & REMONUMENTATION

MAR 03 1998

KENT COUNTY REMONUMENTATION

LAND CORNER RECORDATION CERTIFICATE
Filing Requirement of Act 74, Mich. P.A. 1970

SECTION

For corners in
KENT COUNTY

Located In: Corner Code #

1. Public Land Survey	T 5N R 9W	G-11
	T R	
	T R	
	T R	
2. Property Controlling in Section	S T R	
	S T R	
3. Miscellaneous Property in Sec.	S T R	
	S T R	

REG. OF DEEDS

Lucy Spand

97 APR 29 AM 8:18

STATE OF MICHIGAN
COUNTY OF KENT
RECEIVED FOR RECORD

9745

Register of Deeds Stamp & File Number

4. Lot No. _____, Recorded Plat _____
5. Private Claims _____

I, Kirk Breitels, in a field survey on Jan. 27, 1997 do hereby state that under requirements of P.A. 74, Michigan P.A. of 1970, the corner points mentioned in lines 1 and 2 above were in conformance with regulations and rules therefore as required in the current manual of survey instructions of the United States Department of the Interior, Bureau of Land Management or by a decree of a Court of Law and /or that the corner points mentioned in lines 3, 4 and 5 above were in conformance with the rules of the Michigan Board of Land Surveyors or by a Decree of a Court of Law; established, re-established, monumented, recovered, found as expressed below:

NOTE: Not more than 2 corners, all in the same town and range, may be recorded on this certificate.

1	A	B	C	D	E	F	G	H	I	J	K	L	M
2	6		5		4		3		2		1		
3													
4	7		8		9		10		11		12		
5													
6	18		17		16		15		14		13		
7													
8	19		20		21		22		23		24		
9													
10	30		29		28		27		26		25		
11													
12	31		32		33		34		35		36		
13													

A. Description of original monument and accessories and/or subsequent restoration:

G-11	1830	GLO	Mullett	Set Post
	1944	Kent Co. Wit.		Iron
	1982	LCRC #2934	Bonnema	1/2" Iron
	1982	LCRC #3138	Bonnema	Set Kent County Monument
	1990	LCRC #5380	Starr	Kent County Monument

The position of this corner was previously approved by the Kent County Remonumentation Peer Group, monumented by Douglas W. Bonnema on 11/9/82 and was recorded per LCRC #3138

B. Description of corner evidence found and/or method applied in restoring or reestablishing corner:


G-11 Found standard Kent Co. Mon. (Harrison) per witnesses from above LCRC as set by Douglas W. Bonnema in place of the 1/2" Iron he found. Said Iron checks with Kent Co. Wit. and LCRC #2934.

<u>LCRC #3138</u>	Nail & tag 24" Poplar	S45°E	41.57'	<u>LCRC #5380</u>	SE cor. hse. fnd. N57°W	130.65'
	Nail & tag 12" Maple	S00°E	40.35'		SW cor. hse. fnd. N49°E	122.67'
	Nail & tag 14" Walnut	S75°W	90.32'		Nail/tag S. Pole N68°E	57.03'
	SE cor. hse. fnd.	N55°W	130.54'		Nail/tag S. Pole N20°W	84.30'
	SW cor. hse. fnd.	N65°E	132.95'		Nail/tag 16" Maple South	40.36'
					Nail/tag 24" stump S44°E	41.56'
						24" Walnut
						S76°W 90.32'

The selected location is accepted by me and is generally accepted by professional surveyors as the best available evidence of the position of the original corner.

C. Description of monument for corner and accessories established to perpetuate locating the position of the corner:

G-11 Standard Kent County Monument	Nail & KC Remon. tag NW side Service Pole	N68°E	57.11'
	Nail & KC Remon. tag E. side Service Pole	N20°W	84.30'
	Nail & KC Remon. tag NE side 24" Stump	S44°E	41.59'
	Nail & KC Remon. tag N. side 28" Walnut	S76°W	90.32'
	SE corner house foundation (brick)	N57°W	130.58'
	SW corner house foundation	N49°E	122.60'
	C/L "X" bit. roads N-E-W is South 1'±		

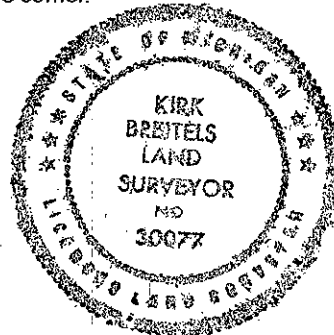

Signed by *Kirk Breitels*
Surveyor's Michigan License No. 30077

Date 3/27/97

P.A. 345 1990 KENT COUNTY

PEER APPROVED 3/27/97
CHAIRMAN *Harry Huber*