

**SURVEY & REMONUMENTATION**

**KENT COUNTY REMONUMENTATION**

**MAR 03 1998**

**LAND CORNER RECORDATION CERTIFICATE**  
Filing Requirement of Act 74, Mich. P.A. 1970

For corners in

**KENT COUNTY SECTION**

(County)

Located In:

Corner Code #

1. Public Land Survey	T	5N	R	9W	G-13
	T		R		
	T		R		
	T		R		
2. Property Controlling in Section	S		T	R	
	S		T	R	
3. Miscellaneous Property in Sec.	S		T	R	
	S		T	R	

STATE OF MICHIGAN  
COUNTY OF KENT  
RECEIVED FOR RECORD  
97 APR 29 AM 8:18  
REG. OF DEEDS  
*Lucy St. Paul*

**9747**

Register of Deeds Stamp & File Number

4. Lot No. \_\_\_\_\_, Recorded Plat \_\_\_\_\_  
5. Private Claims \_\_\_\_\_

I, Kirk Breitels, in a field survey on Mar. 13, 1997 do hereby state that under requirements of P.A. 74, Michigan P.A. of 1970, the corner points mentioned in lines 1 and 2 above were in conformance with regulations and rules therefore as required in the current manual of survey instructions of the United States Department of the Interior, Bureau of Land Management or by a decree of a Court of Law and /or that the corner points mentioned in lines 3, 4 and 5 above were in conformance with the rules of the Michigan Board of Land Surveyors or by a Decree of a Court of Law, established, re-established, monumented, recovered, found as expressed below:

NOTE: Not more than 2 corners, all in the same town and range, may be recorded on this certificate.

A	B	C	D	E	F	G	H	I	J	K	L	M
1												
2	6	5	4	3	2	1						
3												
4	7	8	9	10	11	12						
5												
6	18	17	16	15	14	13						
7												
8	19	20	21	22	23	24						
9												
10	30	29	28	27	26	25						
11												
12	31	32	33	34	35	36						
13												

A. Description of original monument and accessories and/or subsequent restoration:

G-13	1830	GLO	Mullett	Set Post
	1973	LCRC #617	Spicer	3/4" Iron
	1976	Exxel Eng.		Set 1/2" Solid Rod
	1986	LCRC #4420	Jonker	Set Kent County Monument
	1990	LCRC #5381	Starr	Kent County Monument

The position of this corner was previously approved by the Kent County Remonumentation Peer Group, monumented by Robert J. Jonker on 4/8/86 and was recorded per LCRC #4420.

B. Description of corner evidence found and/or method applied in restoring or reestablishing corner:

G-13 Found standard Kent Co. Mon. (Harrison) - LEANNING SOUTHERLY - per witnesses from above LCRC as set by Robert J. Jonker in place of the 1/2" Rerod he found. Rerod checks Exxel Eng. information. LCRC #617 does not fit. RESET Kent Co. Mon. per LCRC #4420.

LCRC #4420			LCRC #5381		
Sq. spike 14" Oak	N30°E	29.42'	Nail & tag 18" Oak	N30°E	29.78'
Remon. tag 18" Tw. Poplar	S40°W	37.53'	Nail & tag 12" Oak	N67°E	71.31'
Remon. tag 10" Oak	N60°E	71.3'	Nail & tag 18" Beech	S25°E	88.64'
Remon. tag 16" Beech	S30°E	88.64'	Nail & tag 12" Poplar	S46°W	14.04'
Iron	North	33'	Nail & tag Tri. 10" Oak	S88°W	32.84'
			1/2" Rerod	West	17.80'
			Capped Rerod	North	33.15'


The selected location is accepted by me and is generally accepted by professional surveyors as the best available evidence of the position of the original corner.

C. Description of monument for corner and accessories established to perpetuate locating the position of the corner:

G-13 Standard Kent County Monument					
Nail & KC Remon. tag SE side	20" Oak	N30°E	29.68'	(29.45' Sq. spike)	
Nail & KC Remon. tag SW side	16" Oak	N67°E	71.30'		
Nail & KC Remon. tag SW side	18" Beech	S25°E	88.69'		
Nail & KC Remon. tag NW side	14" Poplar	S46°W	14.15'		
Nail & KC Remon. tag S. side	Tri. 12" Oak	S88°W	32.80'		
1/2" Rerod		West	17.80'		
Capped Rerod (Exxel)		North	33.00'		

Signed by *Kirk Breitels*  
Surveyor's Michigan License No. 30077

Date 3/27/97

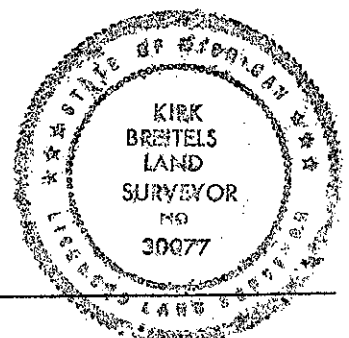

P.A. 345 1990 KENT COUNTY  
PEER APPROVED 3/27/97  
CHAIRMAN *Harry Hubert*