

**SURVEY & REMONUMENTATION**

MAR 03 1998

KENT COUNTY REMONUMENTATION

**SECTION**

**LAND CORNER RECORDATION CERTIFICATE**  
Filing Requirement of Act 74, Mich. P.A. 1970

REG. OF DEEDS  
 97 APR 29 AM 8:18  
 STATE OF MICHIGAN  
 COUNTY OF KENT  
 RECEIVED FOR RECORD

For corners in  
KENT COUNTY

Located In:	Corner Code #
1. Public Land Survey	T 5N R 9W H-3
	T R
	T R
	T R
2. Property Controlling in Section	S T R
	S T R
3. Miscellaneous Property in Sec.	S T R
	S T R

**9749**

Register of Deeds Stamp & File Number

4. Lot No. \_\_\_\_\_, Recorded Plat \_\_\_\_\_  
5. Private Claims \_\_\_\_\_

I, Kirk Breitels, in a field survey on Mar. 6, 1997 do hereby state that under requirements of P.A. 74, Michigan P.A. of 1970, the corner points mentioned in lines 1 and 2 above were in conformance with regulations and rules therefore as required in the current manual of survey instructions of the United States Department of the Interior, Bureau of Land Management or by a decree of a Court of Law and /or that the corner points mentioned in lines 3, 4 and 5 above were in conformance with the rules of the Michigan Board of Land Surveyors or by a Decree of a Court of Law; established, re-established, monumented, recovered, found as expressed below:

NOTE: Not more than 2 corners, all in the same town and range, may be recorded on this certificate.

A	B	C	D	E	F	G	H	I	J	K	L	M
1												
2	6	5			4		3		2		1	
3							●					
4	7	8			9		10		11		12	
5												
6	18	17			16		15		14		13	
7												
8	19	20			21		22		23		24	
9												
10	30	29			28		27		26		25	
11												
12	31	32			33		34		35		36	
13												

A. Description of original monument and accessories and/or subsequent restoration:

H-3	1830	GLO	Mullett	Set Post
	1987	LCRC #4509	Rosema	Set Kent County Monument
	1994	LCRC #7004	Byl	Kent County Monument

The position of this corner was previously approved by the Kent County Remonumentation Peer Group, monumented by Maurice J. Rosema on 4/9/87 and was recorded per LCRC #4509

B. Description of corner evidence found and/or method applied in restoring or reestablishing corner:


H-3 Found standard Kent Co. Mon. (Harrison) per witnesses from above LCRC as set by Maurice J. Rosema.

LCRC #		LCRC #7004
Nail & tag 18" Beech	S87°W 51.50'	Nail & tag 18" Beech S87°W 51.50'
Nail & tag 18" Oak	S15°W 37.93'	Nail & tag 22" Maple S15°W 37.90'
Nail & tag 10" Beech	N05°W 44.54'	Nail & tag 10" Beech N05°W 44.54'
Nail & tag 18" Oak	N25°W 73.45'	Nail & tag 22" Maple N25°W 73.45'
Nail & tag 15" Oak	S78°E 57.36'	Nail & tag 18" Maple S78°E 57.20'

The selected location is accepted by me and is generally accepted by professional surveyors as the best available evidence of the position of the original corner.

C. Description of monument for corner and accessories established to perpetuate locating the position of the corner:

H-3 Standard Kent County Monument	
Nail & KC Remon. tag N. side 20" stump	S87°W 51.50'
Nail & KC Remon. tag E. side 24" stump	S15°W 37.93'
Nail & KC Remon. tag W. side 12" Beech	N05°W 44.54'
Nail & KC Remon. tag W. side 24" stump	N25°W 73.45'
Nail & KC Remon. tag S. side 20" Maple	S78°E 57.20'
Nail & KC Remon. tag NW side 10" Cherry	S50°W 39.12'

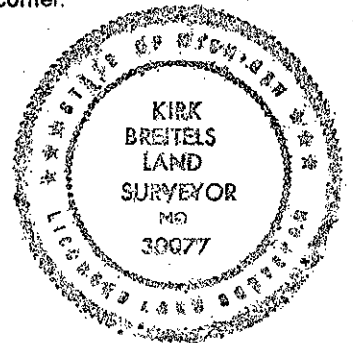

Signed by Kirk Breitels  
Surveyor's Michigan License No. 30077

Date 3/27/97

P.A. 345 1990 KENT COUNTY  
PEER APPROVED 3/27/97  
CHAIRMAN Harry Tubers