

**SURVEY & REMONUMENTATION**

MAR 03 1998

KENT COUNTY REMONUMENTATION

**SECTION**

**LAND CORNER RECORDATION CERTIFICATE**  
Filing Requirement of Act 74, Mich. P.A. 1970

For corners in  
KENT COUNTY

(County)

Located In: Corner Code #

1. Public Land Survey	T <u>5</u> N	R <u>9</u> W	H-4
	T	R	
	T	R	
	T	R	
2. Property Controlling in Section	S	T	R
	S	T	R
3. Miscellaneous Property in Sec.	S	T	R
	S	T	R

STATE OF MICHIGAN  
COUNTY OF KENT  
RECEIVED FOR RECORD  
97 OCT 14 AM 10:01  
REG. OF DEEDS  
*David J. Bond*

10024

Register of Deeds Stamp & File Number

4. Lot No. \_\_\_\_\_, Recorded Plat \_\_\_\_\_  
5. Private Claims \_\_\_\_\_

I, Kirk Breitels, in a field survey on June 16, 1997 do hereby state that under requirements of P.A. 74, Michigan P.A. of 1970, the corner points mentioned in lines 1 and 2 above were in conformance with regulations and rules therefore as required in the current manual of survey instructions of the United States Department of the Interior, Bureau of Land Management or by a decree of a Court of Law and/or that the corner points mentioned in lines 3, 4 and 5 above were in conformance with the rules of the Michigan Board of Land Surveyors or by a Decree of a Court of Law; established, re-established, monumented, recovered, found as expressed below:

NOTE: Not more than 2 corners, all in the same town and range, may be recorded on this certificate.

1	A	B	C	D	E	F	G	H	I	J	K	L	M
2		6		5		4		3		2		1	
3													
4		7		8		9		10		11		12	
5													
6		18		17		16		15		14		13	
7													
8		19		20		21		22		23		24	
9													
10		30		29		28		27		26		25	
11													
12		31		32		33		34		35		36	
13													

A. Description of original monument and accessories and/or subsequent restoration:

H-4 1830---GLO---Not Set  
Williams & Works---No information  
Kent Co. Wits.---No Information  
1968---Survey---Hay---Shows "Iron" at C 1/4 cor.  
1979---Survey---Byl---Iron Pipe at C 1/4 cor.

B. Description of corner evidence found and/or method applied in restoring or reestablishing corner:

H-4 Found Iron Pipe 0.1' N. and 12.6' E. of intersection of 1/4 lines.


Measurements to W 1/4 cor. and E 1/4 cor. agree ± with prev. surveys

Iron Pipe on fence line N-S and fits 1/8 line fences to East & West ±

The Iron Pipe is accepted by me and is generally accepted by professional surveyors as the best available evidence of the position of the corner.

C. Description of monument for corner and accessories established to perpetuate locating the position of the corner:

H-4 Set Standard Kent Co. Monument (Harrison) in place of the Iron Pipe  
Nail & KC Remon. tag N. side 15" Sassafras S60°E 40.75'  
Nail & KC Remon. tag E. side 48" Oak S05°E 23.33'  
Nail & KC Remon. tag N. side 24" Oak S70°W 58.86'  
Nail & KC Remon. tag S. side P. Pole N75°W 96.86'  
Nail & KC Remon. tag SE side 24" Cherry N60°E 48.18'  
On fence lines N-S ± and in C/L E-W grav. rd. ±

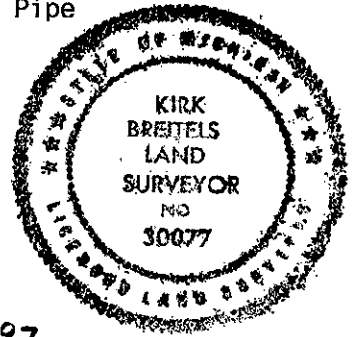

Signed by *Kirk Breitels*  
Surveyor's Michigan License No. 30077

Date 8/28/97

P.A. 345 1990 KENT COUNTY  
PEER APPROVED 7/24/97  
CHAIRMAN *Harry Hubell*