

SURVEY & REMONUMENTATION

MAR 03 1998

KENT COUNTY REMONUMENTATION

SECTION

LAND CORNER RECORDATION CERTIFICATE
Filing Requirement of Act 74, Mich. P.A. 1970

STATE OF MICHIGAN
 COUNTY OF KENT
 RECEIVED FOR RECORD
 97 APR 29 AM 8:19
 REG. OF DEEDS
Lucy Stand

For corners in

<u>KENT COUNTY</u> (County)	Located in:	Corner Code #
1. Public Land Survey	T <u>5N</u> R <u>9W</u>	<u>H-5</u>
	T <u> </u> R <u> </u>	<u> </u>
	T <u> </u> R <u> </u>	<u> </u>
	T <u> </u> R <u> </u>	<u> </u>
2. Property Controlling in Section	S <u> </u> T <u> </u> R <u> </u>	<u> </u>
	S <u> </u> T <u> </u> R <u> </u>	<u> </u>
3. Miscellaneous Property in Sec.	S <u> </u> T <u> </u> R <u> </u>	<u> </u>
	S <u> </u> T <u> </u> R <u> </u>	<u> </u>

9750

Register of Deeds Stamp & File Number

4. Lot No. _____, Recorded Plat _____
 5. Private Claims _____

I, Kirk Breitels, in a field survey on Mar. 3, 1997 do hereby state that under requirements of P.A. 74, Michigan P.A. of 1970, the corner points mentioned in lines 1 and 2 above were in conformance with regulations and rules therefore as required in the current manual of survey instructions of the United States Department of the Interior, Bureau of Land Management or by a decree of a Court of Law and /or that the corner points mentioned in lines 3, 4 and 5 above were in conformance with the rules of the Michigan Board of Land Surveyors or by a Decree of a Court of Law; established, re-established, monumented, recovered, found as expressed below:

NOTE: Not more than 2 corners, all in the same town and range, may be recorded on this certificate.

1	A	B	C	D	E	F	G	H	I	J	K	L	M
2		6		5		4		3		2		1	
3													
4		7		8		9		10		11		12	
5								●					
6		18		17		16		15		14		13	
7													
8		19		20		21		22		23		24	
9													
10		30		29		28		27		26		25	
11													
12		31		32		33		34		35		36	
13													

A. Description of original monument and accessories and/or subsequent restoration:

H-5	1830	GLO	Mullett	Set Post
	1984	LCRC #4062	Jonker	Set Kent County Monument
	1994	LCRC #7005	Byl	Kent County Monument

The position of this corner was previously approved by the Kent County Remonumentation Peer Group, monumented by Robert J. Jonker on 12/14/84 and was recorded per LCRC #4062

B. Description of corner evidence found and/or method applied in restoring or reestablishing corner:


H-5 Found standard Kent Co. Mon. (Harrison) per witnesses from above LCRC as set by Robert J. Jonker in place of an old fence post anchored by stones he found.

<u>LCRC #4062</u>		<u>LCRC #7005</u>
Remon. tag 26" Oak	S80°W 10.09'	Nail & tag 16" Ash N60°W 24.52'
Remon. tag 14" Ash	N60°W 24.43'	Nail & tag 24" Maple S80°E 21.89'
Remon. tag 22" Maple	S80°E 21.82'	Nail & tag 18" Ash N10°W 37.00'
Remon. tag 16" Ash	N10°W 36.79'	Nail & tag 12" Maple S90°W 23.11'

The selected location is accepted by me and is generally accepted by professional surveyors as the best available evidence of the position of the original corner.

C. Description of monument for corner and accessories established to perpetuate locating the position of the corner:

H-5	Standard Kent County Monument
Nail & KC Remon. tag	SW side 16" Ash N60°W 24.52'
Nail & KC Remon. tag	N. side 24" Maple S80°E 21.89'
Nail & KC Remon. tag	W. side 18" Ash N10°W 37.00'
Nail & KC Remon. tag	S. side 12" Maple S90°W 23.11'

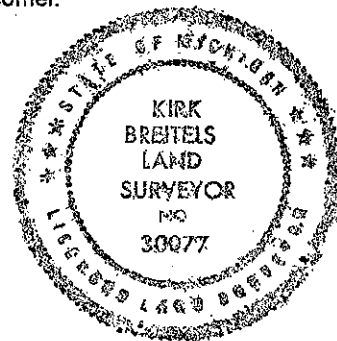

Signed by *Kirk Breitels*
 Surveyor's Michigan License No. 30077

Date 3/27/97

P.A. 345 1990 KENT COUNTY
 PEER APPROVED 3/27/97
 CHAIRMAN *Henry Hubert*