

**SURVEY & REMONUMENTATION**

MAR 03 1998

KENT COUNTY REMONUMENTATION

**LAND CORNER RECORDATION CERTIFICATE**  
Filing Requirement of Act 74, Mich. P.A. 1970

**SECTION**

For corners in

KENT COUNTY

(County)

Located In:

Corner Code #

1. Public Land Survey

T 5N	R 9W	H-7
T	R	
T	R	
T	R	
S	T R	
S	T R	
S	T R	
S	T R	

2. Property Controlling in Section

3. Miscellaneous Property in Sec.

4. Lot No. \_\_\_\_\_, Recorded Plat \_\_\_\_\_  
5. Private Claims \_\_\_\_\_

REG. OF DEEDS

*Eric Brand*

97 OCT 14 AM 10:02

STATE OF MICHIGAN  
COUNTY OF KENT  
RECEIVED FOR RECORD

10025

Register of Deeds Stamp & File Number

I, Kirk Breitels, in a field survey on June 5, 1997 do hereby state that under requirements of P.A. 74, Michigan P.A. of 1970, the corner points mentioned in lines 1 and 2 above were in conformance with regulations and rules therefore as required in the current manual of survey instructions of the United States Department of the Interior, Bureau of Land Management or by a decree of a Court of Law and/or that the corner points mentioned in lines 3, 4 and 5 above were in conformance with the rules of the Michigan Board of Land Surveyors or by a Decree of a Court of Law; established, re-established, monumented, recovered, found as expressed below:

NOTE: Not more than 2 corners, all in the same town and range, may be recorded on this certificate.

A	B	C	D	E	F	G	H	I	J	K	L	M
1												
2	6	5	4	3	2	1						
3												
4	7	8	9	10	11	12						
5												
6	18	17	16	15	14	13						
7												
8	19	20	21	22	23	24						
9												
10	30	29	28	27	26	25						
11												
12	31	32	33	34	35	36						
13												

A. Description of original monument and accessories and/or subsequent restoration:

- H-7 1830---GLO---Mullett---Set Post  
---Williams & Works---No information  
---Kent Co. Wits.---No desc. of corner  
Fe. post 34.5' 20" Maple NE 34.4'
- 1983---LCRC #3290---E. Glaza---Set corner using KCRC Wits.  
Cor. fc. post NW 34.5' 20" Maple NE 34.40' Fc. Post S 30.00'
- 1982---LCRC #3553---VanKooten---Found 1/2" Rod (bent) - reset Capped Iron  
26" Maple ENE 50.85' RR tie post NNE 28.56' P. Pole SSW 84.85'
- 1984---Survey---Jonker---Rerod per LCRC #3553 - no deflection at corner.

B. Description of corner evidence found and/or method applied in restoring or reestablishing corner:


- H-7 Found Re-rod with broken cap per witnesses of LCRC #3553:  
PK S. side 30" Maple ENE 50.83' Meas. defl. 00°00'30" at corner  
PK W. side RR tie post NNE 28.76'  
PK W. side P. Pole SSW 84.81'

Did not find a corner per LCRC #3290 - Jonker notes show this corner to be 20.9' East and 1.8' South of corner per LCRC #3553.

The Re-rod per LCRC #3553 is accepted by me and is generally accepted by professional surveyors as the best available evidence of the original corner.

C. Description of monument for corner and accessories established to perpetuate locating the position of the corner:

- H-7 Set Standard Kent Co. Monument (Harrison) in place of the Re-rod  
Set Nail & KC Remon. tag S. side 30" Maple N65°E 50.83'  
Set Nail & KC Remon. tag W. side RR tie post N10°E 28.82'  
Set Nail & KC Remon. tag W. side P. Pole S20°W 84.81'  
Set Nail & KC Remon. tag SW side 12" Poplar N20°W 46.31'  
C/L E-W asph. road is North 1/5' ±.

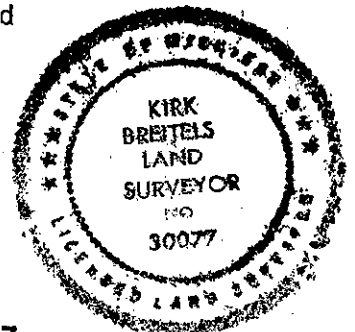

Signed by *Kirk Breitels*  
Surveyor's Michigan License No. 30077

Date 8/28/97

P.A. 345 1990 KENT COUNTY  
PEER APPROVED 6/26/97  
CHAIRMAN *Harrison*