

FEB 14 1997

COMMISSION

**KENT COUNTY REMONUMENTATION  
LAND CORNER RECORDATION CERTIFICATE**  
Filing Requirement of Act 74, Mich. P.A. 1970

For corners in

Kent	Located In:	Corner Code #
(County)	Bowne Twp.	
1. Public Land Survey	T 5N R 9W	H-8
	T ___ R ___	_____
	T ___ R ___	_____
	T ___ R ___	_____
2. Property Controlling in Section	S ___ T ___ R ___	_____
	S ___ T ___ R ___	_____
3. Miscellaneous Property in Sec.	S ___ T ___ R ___	_____
	S ___ T ___ R ___	_____

STATE OF MICHIGAN  
COUNTY OF KENT  
RECEIVED FOR RECORD

95 DEC 18 PM 1:17

REG. OF DEEDS

9595

Register of Deeds Stamp & File Number

4. Lot No. \_\_\_\_\_, Recorded Plat \_\_\_\_\_  
5. Private Claims \_\_\_\_\_

I, Robert Jonker, in a field survey on 12-05, 1996 do hereby state that under requirements of P.A. 74, Michigan P.A. of 1970, the corner points mentioned in lines 1 and 2 above were in conformance with regulations and rules therefore as required in the current manual of survey instructions of the United States Department of the Interior, Bureau of Land Management or by a decree of a Court of Law and /or that the corner points mentioned in lines 3, 4 and 5 above were in conformance with the rules of the Michigan Board of Land Surveyors or by a Decree of a Court of Law; established, re-established, monumented, recovered, found as expressed below:

NOTE: Not more than 2 corners, all in the same town and range, may be recorded on this certificate.

	A	B	C	D	E	F	G	H	I	J	K	L	M
1													
2	6	5	4	3	2	1							
3													
4	7	8	9	10	11	12							
5													
6	18	17	16	15	14	13							
7													
8	19	20	21	22	23	24							
9													
10	30	29	28	27	26	25							
11													
12	31	32	33	34	35	36							
13													

A. Description of original monument and accessories and/or subsequent restoration:  
Not set in GLO survey and no recorded info.  
No historical info. available from local surveyors


P.A. 345 1990 KENT COUNTY  
PEER APPROVED 12/5/96  
CHAIRMAN Harry Huber

B. Description of corner evidence found and/or method applied in restoring or reestablishing corner:  
Set at int. of 1/4 lines  
Falls @ int. of N-S fence & fence to East (all lying down)

Accepted as the best available evidence of the position of the corner.  
Approved by the Kent County Peer Group on December 05, 1996.

C. Description of monument for corner and accessories established to perpetuate locating the position of the corner:  
Standard Kent County monument (Harrison)

- K.C. Remon N & T - E'ly side 24" Oak S 30° E 14.09'
- K.C. Remon N & T - N. side 12" Oak S 65° E 34.09'
- K.C. Remon N & T - S. side 16" Oak S 80° W 43.63'
- K.C. Remon N & T - W. side 16" Oak N 15° W 26.55'

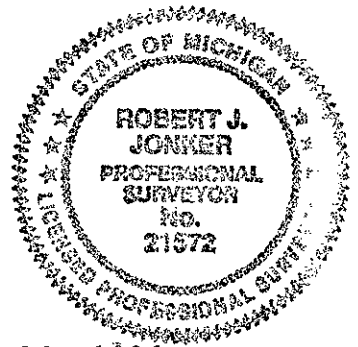

Signed by Robert J. Jonker  
Surveyor's Michigan License No. 21572

Date December 06, 1996