

SURVEY & REMONUMENTATION

MAR 03 1998

KENT COUNTY REMONUMENTATION

LAND CORNER RECORDATION CERTIFICATE
Filing Requirement of Act 74, Mich. P.A. 1970

STATE OF MICHIGAN
 COUNTY OF KENT
 RECEIVED FOR RECORD
 7 APR 29 AM 8:19
 REG. OF DEEDS
Lucy Stand

SECTION

For corners in

KENT COUNTY

(County)

Located In:

Corner Code #

- | | | |
|------------------------------------|--|------------|
| 1. Public Land Survey | T <u>5</u> N R <u>9</u> W | I-5 |
| | T <u> </u> R <u> </u> | <u> </u> |
| | T <u> </u> R <u> </u> | <u> </u> |
| | T <u> </u> R <u> </u> | <u> </u> |
| 2. Property Controlling in Section | S <u> </u> T <u> </u> R <u> </u> | <u> </u> |
| | S <u> </u> T <u> </u> R <u> </u> | <u> </u> |
| 3. Miscellaneous Property in Sec. | S <u> </u> T <u> </u> R <u> </u> | <u> </u> |
| | S <u> </u> T <u> </u> R <u> </u> | <u> </u> |

9758

Register of Deeds Stamp & File Number

4. Lot No. _____, Recorded Plat _____
 5. Private Claims _____

I, Kirk Breitels, in a field survey on Jan. 29, 1997 do hereby state that under requirements of P.A. 74, Michigan P.A. of 1970, the corner points mentioned in lines 1 and 2 above were in conformance with regulations and rules therefore as required in the current manual of survey instructions of the United States Department of the Interior, Bureau of Land Management or by a decree of a Court of Law and/or that the corner points mentioned in lines 3, 4 and 5 above were in conformance with the rules of the Michigan Board of Land Surveyors or by a Decree of a Court of Law; established, re-established, monumented, recovered, found as expressed below:

NOTE: Not more than 2 corners, all in the same town and range, may be recorded on this certificate.

	A	B	C	D	E	F	G	H	I	J	K	L	M
1													
2	6		5		4		3		2		1		
3													
4	7		8		9		10		11		12		
5													
6	18		17		16		15		14		13		
7													
8	19		20		21		22		23		24		
9													
10	30		29		28		27		26		25		
11													
12	31		32		33		34		35		36		
13													

A. Description of original monument and accessories and/or subsequent restoration:

I-5	1830	GLO	Mullett	Set Post
	1937	Kent Co. Wit.		Iron on Plow Point
	1983	LCRC #3441	McCombs	Mon. Box
	1983	LCRC #3602	Kolehouse	Set Kent County Monument in Mon. Box
	1994	LCRC #7013	Byl	Kent County Monument in Mon. Box

The position of this corner was previously approved by the Kent County Remonumentation Peer Group, monumented by Randy J. Kolehouse on 11/9/83 and was recorded per LCRC #3602

B. Description of corner evidence found and/or method applied in restoring or reestablishing corner:


I-5 Found standard Kent Co. Mon. (Harrison) per witnesses from above LCRC as set by Randy J. Kolehouse in place of the 1/2" Iron over a 1" Iron he found inside a Mon. Box. Both Irons check with Kent Co. Wit. and LCRC #3602.

<u>LCRC #3602</u>		<u>LCRC #7013</u>	
Nail & tag 36" Maple	N35°E 50.30'	Nail & tag 36" Maple	N35°E 50.30'
Nail & tag 12" Elm	S30°E 72.90'	Nail & tag 18" Hickory	N60°W 34.68'
Nail & tag 12" Hickory	N60°W 34.82'	SE corner garage	N80°W 62.30'
SE cor. garage	N80°W 62.30'	Nail & tag guard post	S10°W 75.15'
		SW cor. conc. pad (MBT)	N60°E 58.22'

The selected location is accepted by me and is generally accepted by professional surveyors as the best available evidence of the position of the original corner.

C. Description of monument for corner and accessories established to perpetuate locating the position of the corner:

I-5 Standard Kent County Monument in Mon. Box	
Nail & KC Remon. tag SW root 36" Maple	N35°E 50.30'
Nail & KC Remon. tag S. side 18" Hickory	N60°W 34.68'
SE corner garage	N80°W 62.30'
Nail & KC Remon. tag top of guard post	S10°W 75.15'
SW corner concrete pad of MBT pedestal	N60°E 58.22'

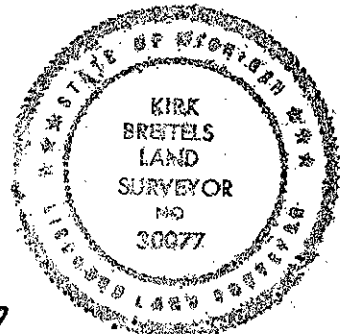

Signed by *Kirk Breitels*
 Surveyor's Michigan License No. 30077

Date 3/27/97

P.A. 345 1990 KENT COUNTY
 PEER APPROVED 3/27/97
 CHAIRMAN *Randy Kolehouse*