

**SURVEY & REMONUMENTATION**

MAR 03 1998

KENT COUNTY REMONUMENTATION

**LAND CORNER RECORDATION CERTIFICATE**  
Filing Requirement of Act 74, Mich. P.A. 1970

SECTION

For corners in

KENT COUNTY  
(County)

Located In:

Corner Code #

- 1. Public Land Survey      T 5N R 9W      I-7
- T    R
- T    R
- T    R
- 2. Property Controlling    S    T    R
- in Section                S    T    R
- 3. Miscellaneous            S    T    R
- Property in Sec.         S    T    R

STATE OF MICHIGAN  
 COUNTY OF KENT  
 RECEIVED FOR RECORD  
 97 APR 29 AM 8:19  
 REG. OF DEEDS  
*David Bond*

9760

Register of Deeds Stamp & File Number

- 4. Lot No. \_\_\_\_\_, Recorded Plat \_\_\_\_\_
- 5. Private Claims \_\_\_\_\_

I, Kirk Breitels, in a field survey on Jan. 29, 1997 do hereby state that under requirements of P.A. 74, Michigan P.A. of 1970, the corner points mentioned in lines 1 and 2 above were in conformance with regulations and rules therefore as required in the current manual of survey instructions of the United States Department of the Interior, Bureau of Land Management or by a decree of a Court of Law and /or that the corner points mentioned in lines 3, 4 and 5 above were in conformance with the rules of the Michigan Board of Land Surveyors or by a Decree of a Court of Law; established, re-established, monumented, recovered, found as expressed below:

NOTE: Not more than 2 corners, all in the same town and range, may be recorded on this certificate.

|    |   |    |   |    |   |    |   |    |   |    |   |    |   |
|----|---|----|---|----|---|----|---|----|---|----|---|----|---|
| 1  | A | B  | C | D  | E | F  | G | H  | I | J  | K | L  | M |
| 2  |   | 6  |   | 5  |   | 4  |   | 3  |   | 2  |   | 1  |   |
| 3  |   |    |   |    |   |    |   |    |   |    |   |    |   |
| 4  |   | 7  |   | 8  |   | 9  |   | 10 |   | 11 |   | 12 |   |
| 5  |   |    |   |    |   |    |   |    |   |    |   |    |   |
| 6  |   | 18 |   | 17 |   | 16 |   | 15 |   | 14 |   | 13 |   |
| 7  |   |    |   |    |   |    |   |    |   |    |   |    |   |
| 8  |   | 19 |   | 20 |   | 21 |   | 22 |   | 23 |   | 24 |   |
| 9  |   |    |   |    |   |    |   |    |   |    |   |    |   |
| 10 |   | 30 |   | 29 |   | 28 |   | 27 |   | 26 |   | 25 |   |
| 11 |   |    |   |    |   |    |   |    |   |    |   |    |   |
| 12 |   | 31 |   | 32 |   | 33 |   | 34 |   | 35 |   | 36 |   |
| 13 |   |    |   |    |   |    |   |    |   |    |   |    |   |

A. Description of original monument and accessories and/or subsequent restoration:

|     |      |               |           |                                      |
|-----|------|---------------|-----------|--------------------------------------|
| I-7 | 1830 | GLO           | Mullett   | Set Post                             |
|     | 1937 | Kent Co. Wit. |           | 1" Iron                              |
|     | 1986 | LCRC #3441    | McCombs   | 3/4" Pipe in Mon. Box                |
|     | 1986 | LCRC #3600    | Kolehouse | Set Kent County Monument in Mon. Box |
|     | 1994 | LCRC #7015    | Byl       | Kent County Monument                 |

The position of this corner was previously approved by the Kent County Remonumentation Peer Group, monumented by Randy J. Kolehouse on 11/5/81 and was recorded per LCRC #3600

B. Description of corner evidence found and/or method applied in restoring or reestablishing corner:


I-7 Found standard Kent Co. Mon. (Harrison) per witnesses from above LCRC as set by Randy J. Kolehouse in place of the 1" Iron he found inside a Mon. Box. Said Iron checks with Kent Co. Wit. and LCRC #3441.

|                         |       |        |                       |                   |        |  |  |
|-------------------------|-------|--------|-----------------------|-------------------|--------|--|--|
| <u>LCRC #3600</u>       |       |        |                       | <u>LCRC #7015</u> |        |  |  |
| Nail & tag P. Pole      | S50°W | 55.35' | Nail & tag P. Pole    | S50°W             | 55.35' |  |  |
| Nail & tag P. Pole      | S50°E | 56.12' | Nail & tag P. Pole    | S50°E             | 56.18' |  |  |
| C/L W. end 12" Culv.    | S20°W | 68.95' | C/L W. end 12" culv.  | S20°W             | 68.95' |  |  |
| SW cor. conc. MBT riser | N40°E | 52.65' | SW cor. conc. pad MBT | N40°E             | 52.57' |  |  |

The selected location is accepted by me and is generally accepted by professional surveyors as the best available evidence of the position of the original corner.

C. Description of monument for corner and accessories established to perpetuate locating the position of the corner:

|     |   |       |        |
|-----|---|-------|--------|
| I-7 | Standard Kent County Monument in Mon. Box |       |        |
|     | Nail & KC Remon. tag SE side P. Pole      | S50°W | 55.35' |
|     | Nail & KC Remon. tag SW side P. Pole      | S50°E | 56.18' |
|     | C/L W. end 12" conc. culvert              | S20°W | 68.95' |
|     | SW cor. conc. pad for MBT riser           | N40°E | 52.57' |
|     | On C/L "X" roads                          |       |        |

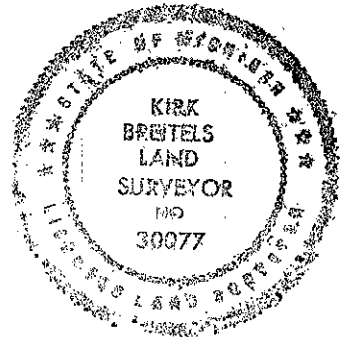

Signed by *Kirk Breitels*  
 Surveyor's Michigan License No. 30077

Date 3/27/97

P.A. 345 1990 KENT COUNTY

PEER APPROVED 13/27/97

CHAIRMAN *Randy Kolehouse*