

SURVEY & REMONUMENTATION

MAR 03 1998

KENT COUNTY REMONUMENTATION

SECTION

LAND CORNER RECORDATION CERTIFICATE
Filing Requirement of Act 74, Mich. P.A. 1970

For corners in

KENT COUNTY

(County)

Located In:

Corner Code #

1. Public Land Survey	T 5N R 9W	I-8
	T _____ R _____	_____
	T _____ R _____	_____
	T _____ R _____	_____
2. Property Controlling in Section	S _____ T _____ R _____	_____
	S _____ T _____ R _____	_____
3. Miscellaneous Property in Sec.	S _____ T _____ R _____	_____
	S _____ T _____ R _____	_____

4. Lot No. _____, Recorded Plat _____
5. Private Claims _____

REG. OF DEEDS

Lucy Bond

97 APR 29 AM 8:19

STATE OF MICHIGAN
COUNTY OF KENT
RECEIVED FOR RECORD

9761

Register of Deeds Stamp & File Number

I, Kirk Breiteis, in a field survey on Feb. 7, 1997 do hereby state that under requirements of P.A. 74, Michigan P.A. of 1970, the corner points mentioned in lines 1 and 2 above were in conformance with regulations and rules therefore as required in the current manual of survey instructions of the United States Department of the Interior, Bureau of Land Management or by a decree of a Court of Law and /or that the corner points mentioned in lines 3, 4 and 5 above were in conformance with the rules of the Michigan Board of Land Surveyors or by a Decree of a Court of Law; established, re-established, monumented, recovered, found as expressed below:

NOTE: Not more than 2 corners, all in the same town and range, may be recorded on this certificate.

A	B	C	D	E	F	G	H	I	J	K	L	M
1												
2	6	5	4	3	2	1						
3												
4	7	8	9	10	11	12						
5												
6	18	17	16	15	14	13						
7												
8	19	20	21	22	23	24						
9												
10	30	29	28	27	26	25						
11												
12	31	32	33	34	35	36						
13												

A. Description of original monument and accessories and/or subsequent restoration:

I-8	1830	GLO	Mullett	Set Post
	1983	Survey	Jonker	Found "T" Iron
	1996	LCRC #9602	Jonker	Set Kent County Monument

The position of this corner was previously approved by the Kent County Remonumentation Peer Group, monumented by Robert J. Jonker on 12/6/96 and was recorded per LCRC #9602

B. Description of corner evidence found and/or method applied in restoring or reestablishing corner:

I-8 Found standard Kent Co. Mon. (Harrison) per witnesses from above LCRC as set by Robert J. Jonker in place of the "T" Iron he found. Said "T" Iron checks with previous survey data and physical evidence.


LCRC #9602

Nail & KC Remon. tag S. side 10" Poplar	N85°E	88.32'
Nail & KC Remon. tag E. side 8" W. Cherry	N10°W	136.14'
Nail & KC Remon. tag E. side 12" Willow	S40°W	42.53'
Nail & KC Remon. tag W. side fence post	S10°E	152.25'

The selected location is accepted by me and is generally accepted by professional surveyors as the best available evidence of the position of the original corner.

C. Description of monument for corner and accessories established to perpetuate locating the position of the corner:

I-8 Standard Kent County Monument (wit. meas. EDM)		
Nail & KC Remon. tag S. side 12" Poplar	N85°E	88.32'
Nail & KC Remon. tag E. side 10" W. Cherry	N10°W	136.06'
Nail & KC Remon. tag E. side 15" Willow	S40°W	42.57'
Nail & KC Remon. tag W. side fence post	S10°E	152.12'

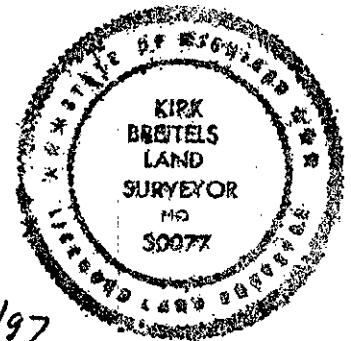

Signed by

Kirk Breiteis

Date

3/27/97

Surveyor's Michigan License No. 30077

P.A. 345 1990 KENT COUNTY

PEER APPROVED 3/29/97
CHAIRMAN *Harry Huber*