

SURVEY & REMONUMENTATION

MAR 03 1998

KENT COUNTY REMONUMENTATION

SECTION

LAND CORNER RECORDATION CERTIFICATE Filing Requirement of Act 74, Mich. P.A. 1970

For corners in
KENT COUNTY
(County)

Located In:	Corner Code #
T 5N R 9W	I-13
T R	
T R	
T R	
S T R	
S T R	
S T R	
S T R	

- Public Land Survey
- Property Controlling in Section
- Miscellaneous Property in Sec.

REG. OF DEEDS

Handwritten signature

97 APR 29 AM 8:19

STATE OF MICHIGAN
COUNTY OF KENT
RECEIVED FOR RECORD

9764

Register of Deeds Stamp & File Number

- Lot No. _____, Recorded Plat _____
- Private Claims _____

	A	B	C	D	E	F	G	H	I	J	K	L	M
1													
2	6		5		4		3		2		1		
3													
4	7		8		9		10		11		12		
5													
6	18		17		16		15		14		13		
7													
8	19		20		21		22		23		24		
9													
10	30		29		28		27		26		25		
11													
12	31		32		33		34		35		36		
13													

I, Kirk Breitels, in a field survey on Mar. 13, 1997 do hereby state that under requirements of P.A. 74, Michigan P.A. of 1970, the corner points mentioned in lines 1 and 2 above were in conformance with regulations and rules therefore as required in the current manual of survey instructions of the United States Department of the Interior, Bureau of Land Management or by a decree of a Court of Law and /or that the corner points mentioned in lines 3, 4 and 5 above were in conformance with the rules of the Michigan Board of Land Surveyors or by a Decree of a Court of Law, established, re-established, monumented, recovered, found as expressed below:

NOTE: Not more than 2 corners, all in the same town and range, may be recorded on this certificate.

A. Description of original monument and accessories and/or subsequent restoration:

I-13	1830	GLO	Mullett	Set Post
	1944	Kent Co. Wit.		Pipe
	1980	LCRC #1319	VanLaar	3/4" Iron
	1981	LCRC #1713	Merdzinski	Set Kent County Monument
	1994	LCRC #6981	Byl	Kent County Monument

The position of this corner was previously approved by the Kent County Remonumentation Peer Group, monumented by John A. Merdzinski on 2/16/81 and was recorded per LCRC #1713

B. Description of corner evidence found and/or method applied in restoring or reestablishing corner:


I-13 Found standard Kent Co. Mon. (Harrison) per witnesses from above LCRC as set by John A. Merdzinski in place of the 3/4" Iron he found. Said Iron checks with Kent Co. witnesses and LCRC #1319.

LCRC #1713	LCRC #6981
Nail & tag 10" Elm N44°E 74.91'	Nail & tag 10"-18" Ash cl. S80°W 82.85'
Nail & tag 18" Oak S10°W 100.54'	Nail & tag 12" Elm N48°W 31.59'
Nail & tag 10" Ash cl. S80°W 82.89'	Nail & tag 10" Elm N70°E 48.68'
Nail & tag 10" Elm N48°W 31.64'	Nail & tag 10" Elm S45°E 35.62'
Nail & tag 6" Tw. Walnut N63°W 77.19'	Nail & tag 15" Willow N30°E 22.46'
Nail & tag 6" Tw. Ash N75°E 49.44'	

The selected location is accepted by me and is generally accepted by professional surveyors as the best available evidence of the position of the original corner.

C. Description of monument for corner and accessories established to perpetuate locating the position of the corner:

I-13 Standard Kent County Monument	
Nail & KC Remon. tag N. side 10"-18" Ash clump	S80°W 82.85'
Nail & KC Remon. tag S. side 12" Elm	N48°W 31.59'
Nail & KC Remon. tag S. side 10" Elm	N70°E 48.68'
Nail & KC Remon. tag N. side 10" Elm	S45°E 35.62'
Nail & KC Remon. tag E. side 15" Willow	N30°E 22.46'
C/L E-W grav. rd. is 3'± North	
On tree row to North ±	

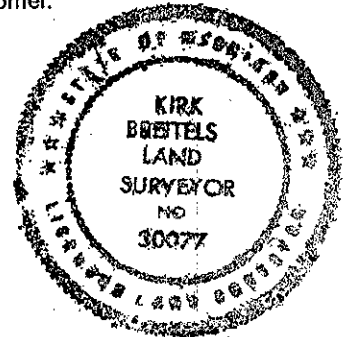

Signed by Kirk Breitels
Surveyor's Michigan License No. 30077

Date 3/27/97

P.A. 345 1990 KENT COUNTY

PEER APPROVED 13/27/97

CHAIRMAN Harry Hubers