

**SURVEY & REMONUMENTATION**

APR 27 1995

KENT COUNTY REMONUMENTATION

STATE OF MICHIGAN  
COUNTY OF KENT  
RECEIVED FOR RECORD  
94 OCT 13 AM 9:33

COMMISSION

**LAND CORNER RECORDATION CERTIFICATE**  
Filing Requirement of Act 74, Mich. P.A. 1970

For corners in  
KENT COUNTY  
(County)

BOWNE TWP.

Located In: Corner Code #

1. Public Land Survey	T	5N	R	9W	J-2 C 1/4 cor.
	T		R		Sec. 2
	T		R		
	T		R		
2. Property Controlling in Section	S		T	R	
	S		T	R	
3. Miscellaneous Property in Sec.	S		T	R	
	S		T	R	

*W. J. Bond*  
REG. OF DEEDS

7141

Register of Deeds Stamp & File Number

4. Lot No. \_\_\_\_\_, Recorded Plat \_\_\_\_\_  
5. Private Claims \_\_\_\_\_

	A	B	C	D	E	F	G	H	I	J	K	L	M
2	6	5	4	3	2	1							
3													
4	7	8	9	10	11	12							
5													
6	18	17	16	15	14	13							
7													
8	19	20	21	22	23	24							
9													
10	30	29	28	27	26	25							
11													
12	31	32	33	34	35	36							
13													

I, William R. Byl, in a field survey on Aug. 9, 1994, do hereby certify that under requirements of P.A. 74, Michigan P.A. of 1970, the corner points mentioned in lines 1 and 2 above were in conformance with regulations and rules therefore as required in the current manual of survey instructions of the United States Department of the Interior, Bureau of Land Management or by a decree of a Court of Law and/or that the corner points mentioned in lines 3, 4 and 5 above were in conformance with the rules of the Michigan Board of Land Surveyors or by a Decree of a Court of Law; established, re-established, monumented, re-monumented, recovered, found as expressed below:

NOTE: Not more than 4 corners, all in the same town and range, may be recorded on this certificate.

A. Description of original monument and accessories and/or subsequent restoration:

J-2 Steel Bar & cap #23502 at intersection of 1/4 lines (LCRC #3514, Sept. 21, 1983)  
 Nail N. side Fc. Post WNW 46.68'  
 Nail E. side 8" Ash SSE 60.31'  
 Nail N. side 6" Aspen ESE 76.07'  
 C/L Power Lines W 34' m/l  
 Iron & cap #23502 S 33.00'

No information about J-2 prior to above G.L.O. did not set.

B. Description of corner evidence found and/or method applied in restoring or reestablishing corner:

J-2 Found Steel Bar & cap #23502  
 Fd. Nail N. side Fc. Post N60°W 46.68'  
 C/L 10" Ash S05°E 60'  
 Steel bar & "mangled" cap (next to fc. post) S00°E 33.12'  
 C/L Power Lines N-S, West 34' m/l


P.A. 345 1990 KENT COUNTY

PEER APPROVED 9/22/94

CHAIRMAN *Stan Hebert*

C. Description of monument for corner and accessories established to perpetuate locating the position of the corner:

J-2 Set Standard Kent County Monument in place of steel bar & cap #23502.  
 Set Nail & KC Remon. tag S. side fence post N60°W 46.67'  
 Set Nail & KC Remon. tag E. side 10" Ash S05°E 59.84'  
 Set Nail & KC Remon. tag N. side 12" Elm S70°W 87.12'  
 Set Nail & KC Remon. tag NE side 6" Poplar S45°E 46.18'  
 Tree line to North is East 5' m/l  
 Distances & bearings (assumed) to: E 1/4 cor. = N 90°00'00" E 2630.88'  
 W 1/4 cor. = S 90°00'00" W 2619.48'  
 N 1/4 cor. = N 00°10'20" W 2735.07'  
 S 1/4 cor. = S 00°10'20" E 2640.83'

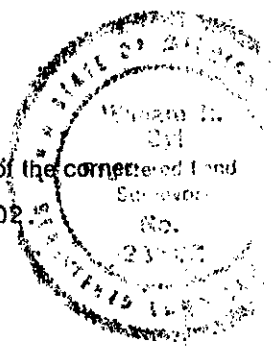

Signed by *W. R. Byl*  
 Surveyor's Michigan License No. 23502

Date 09-27-94