

**SURVEY & REMONUMENTATION**

**MAR 03 1998**

**KENT COUNTY REMONUMENTATION**

**SECTION**

**LAND CORNER RECORDATION CERTIFICATE**  
Filing Requirement of Act 74, Mich. P.A. 1970

For corners in  
**KENT COUNTY**

Located In:	Corner Code #
T 5N R 9W	J-3
T R	
T R	
T R	
T R	
S T R	
S T R	
S T R	
S T R	

1. Public Land Survey

2. Property Controlling in Section

3. Miscellaneous Property in Sec.

4. Lot No. \_\_\_\_\_, Recorded Plat \_\_\_\_\_  
5. Private Claims \_\_\_\_\_

I, Kirk Breitels, in a field survey on Feb. 27, 1997 do hereby state that under requirements of P.A. 74, Michigan P.A. of 1970, the corner points mentioned in lines 1 and 2 above were in conformance with regulations and rules therefore as required in the current manual of survey instructions of the United States Department of the Interior, Bureau of Land Management or by a decree of a Court of Law and/or that the corner points mentioned in lines 3, 4 and 5 above were in conformance with the rules of the Michigan Board of Land Surveyors or by a Decree of a Court of Law; established, re-established, monumented, recovered, found as expressed below:

NOTE: Not more than 2 corners, all in the same town and range, may be recorded on this certificate.

**A. Description of original monument and accessories and/or subsequent restoration:**

Date	Surveyor	Monument
J-3 1830	GLO Mullett	Set Post
1943	Kent Co. Wit.	1 1/2" Iron Pipe
1976	LCRC #998	1 1/2" Iron Pipe
1981	LCRC #2250	Set Kent County Monument
1994	LCRC #6982	Kent County Monument

The position of this corner was previously approved by the Kent County Remonumentation Peer Group, monumented by Robert J. Jonker on 11/6/81 and was recorded per LCRC #2250.

**B. Description of corner evidence found and/or method applied in restoring or reestablishing corner:**


J-3 Found standard Kent Co. Mon. (Harrison) per witnesses from above LCRC as set by Robert J. Jonker in place of the 1 1/2" Iron Pipe he found. Said Iron Pipe checks with Kent Co. Wit. and LCRC #998.

LCRC #2250	LCRC #6982
Remon. tag 24" Oak	S67°W 49.92' Nail & tag 28" Oak
Remon. tag 24" Maple	S01°E 54.10' Nail & tag 28" Maple
Remon. tag 18" Tw. Maple	S35°E 25.36' Nail & tag 22" Tw. Maple
Remon. tag 18" Ash	S56°E 37.38' Nail & tag 20" Ash
SW Vert. face conc. MH	N74°E 67.42' SW Vert. face to conc. MH

The selected location is accepted by me and is generally accepted by professional surveyors as the best available evidence of the position of the original corner.

**C. Description of monument for corner and accessories established to perpetuate locating the position of the corner:**

Monument	Measurement
J-3 Standard Kent County Monument	S67°W 49.88'
Spike NW side 28" Oak	S01°E 54.04'
Spike W. side 28" Maple	S35°E 25.36'
Nail & KC Remon. tag NE side Tw. 22" Maple	S56°E 37.38'
Nail & KC Remon. tag SW side 20" Ash	N74°E 67.82'
SW Vertical face to conc. MH	
In line old fence to South & field line North	
On C/L E-W gravel road ±	

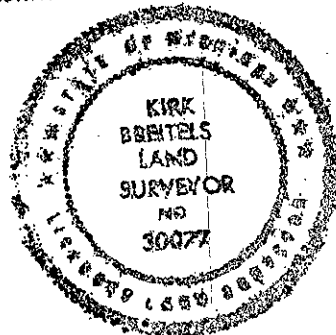

Signed by Kirk Breitels  
Surveyor's Michigan License No. 30077

Date 3/27/97

P.A. 345 1990 KENT COUNTY  
PEER APPROVED 3/27/97  
CHAIRMAN [Signature]

STATE OF MICHIGAN  
COUNTY OF KENT  
RECEIVED FOR RECORDING  
97 APR 29 AM 8:19  
REG. OF DEEDS  
[Signature]  
9766  
Register of Deeds Stamp & File Number

