

SURVEY & REMONUMENTATION

MAR 03 1998

KENT COUNTY REMONUMENTATION

LAND CORNER RECORDATION CERTIFICATE
Filing Requirement of Act 74, Mich. P.A. 1970

SECTION

For corners in
KENT COUNTY

Located In:	Corner Code #
T 5N R 9W	J-4
T R	
T R	
T R	
T R	
S T R	
S T R	
S T R	
S T R	

- 1. Public Land Survey
- 2. Property Controlling in Section
- 3. Miscellaneous Property in Sec.

STATE OF MICHIGAN
COUNTY OF KENT
RECEIVED FOR RECORDING
97 NOV 13 PM 1:01
REG. OF DEEDS
Lucy Stand

10267

Register of Deeds Stamp & File Number

- 4. Lot No. _____, Recorded Plat _____
- 5. Private Claims _____

I, Kirk Breitels, in a field survey on Sept. 9, 1997 do hereby state that under requirements of P.A. 74, Michigan P.A. of 1970, the corner points mentioned in lines 1 and 2 above were in conformance with regulations and rules therefore as required in the current manual of survey instructions of the United States Department of the Interior, Bureau of Land Management or by a decree of a Court of Law and/or that the corner points mentioned in lines 3, 4 and 5 above were in conformance with the rules of the Michigan Board of Land Surveyors or by a Decree of a Court of Law; established, re-established, monumented, recovered, found as expressed below:

	A	B	C	D	E	F	G	H	I	J	K	L	M
1													
2	6		5		4		3		2		1		
3													
4	7		8		9		10		11		12		
5													
6	18		17		16		15		14		13		
7													
8	19		20		21		22		23		24		
9													
10	30		29		28		27		26		25		
11													
12	31		32		33		34		35		36		
13													

NOTE: Not more than 2 corners, all in the same town and range, may be recorded on this certificate.

- A. Description of original monument and accessories and/or subsequent restoration:
J-4 1830---GLO---Not Set
Williams & Works---No Information
Kent Co. Wits.---No Information

P.A. 345 1990 KENT COUNTY
PEER APPROVED 9/25/97
CHAIRMAN *Kang Huber*


- B. Description of corner evidence found and/or method applied in restoring or reestablishing corner:
J-4 Established intersection of 1/4 lines and found nothing at corner.

On line ± with fence South, East-West fence is 5'± North

Computed 1/8 line agrees ± with 1974 Hay survey

The intersection of 1/4 lines is accepted by me and is generally accepted by professional surveyors as the best available evidence of the position of the corner.

- C. Description of monument for corner and accessories established to perpetuate locating the position of the corner:
J-4 Set Standard Kent Co. Monument (Harrison) at the intersection of 1/4 lines.
Nail & KC Remon. tag W. side Tw. 8" Hickory S15°W 9.58'
Nail & KC Remon. tag NE side 12" Cherry S30°E 12.62'
Nail & KC Remon. tag N. side 12" Cherry N75°E 17.56'
Nail & KC Remon. tag E. side 12" Oak N25°E 49.83'
Nail & KC Remon. tag S. side 12" Ash N70°W 12.26'

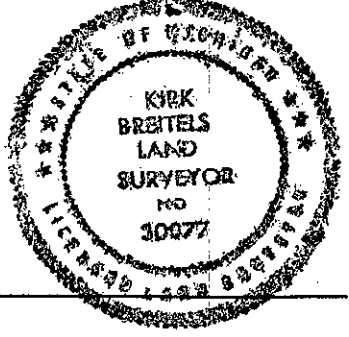

Signed by *Kirk Breitels*
Surveyor's Michigan License No. 30077

Date 10/30/97