

SURVEY & REMONUMENTATION

KENT COUNTY REMONUMENTATION

MAR 03 1998

LAND CORNER RECORDATION CERTIFICATE
 Filing Requirement of Act 74, Mich. P.A. 1970

For corners in **SECTION**
KENT COUNTY

Located In: Corner Code #

1. Public Land Survey	T <u>5N</u> R <u>9W</u>	<u>J-5</u>
	T _____ R _____	_____
	T _____ R _____	_____
	T _____ R _____	_____
2. Property Controlling in Section	S _____ T _____ R _____	_____
	S _____ T _____ R _____	_____
3. Miscellaneous Property in Sec.	S _____ T _____ R _____	_____
	S _____ T _____ R _____	_____

STATE OF MICHIGAN
 COUNTY OF KENT
 RECEIVED FOR RECORD
 97 APR 29 AM 8:19
 REG. OF DEEDS
Luci St. Paul

9767

Register of Deeds Stamp & File Number

4. Lot No. _____, Recorded Plat _____
 5. Private Claims _____

I, Kirk Breitels, in a field survey on Feb. 27, 1997 do hereby state that under requirements of P.A. 74, Michigan P.A. of 1970, the corner points mentioned in lines 1 and 2 above were in conformance with regulations and rules therefore as required in the current manual of survey instructions of the United States Department of the Interior, Bureau of Land Management or by a decree of a Court of Law and /or that the corner points mentioned in lines 3, 4 and 5 above were in conformance with the rules of the Michigan Board of Land Surveyors or by a Decree of a Court of Law; established, re-established, monumented, recovered, found as expressed below:

1	A	B	C	D	E	F	G	H	I	J	K	L	M
2		6		5		4		3		2		1	
3													
4		7		8		9		10		11		12	
5										●			
6		18		17		16		15		14		13	
7													
8		19		20		21		22		23		24	
9													
10		30		29		28		27		26		25	
11													
12		31		32		33		34		35		36	
13													

NOTE: Not more than 2 corners, all in the same town and range, may be recorded on this certificate.

A. Description of original monument and accessories and/or subsequent restoration:

J-5	1830	GLO	Mullett	Set Post
	1937	Kent Co. Wit.		Iron & Stone
	1976	Consumers Power Co.		3/4" Iron
	1984	LCRC #4063	Jonker	Set Kent County Monument
	1994	LCRC #6983	Byl	Kent County Monument

The position of this corner was previously approved by the Kent County Remonumentation Peer Group, monumented by Robert J. Jonker on 12/14/84 and was recorded per LCRC #4063

B. Description of corner evidence found and/or method applied in restoring or reestablishing corner:


J-5 Found standard Kent Co. Mon. (Harrison) per witnesses from above LCRC as set by Robert J. Jonker in place of the 3/4" Iron he found. Said 3/4" Iron checks with Kent Co. Wit. and Consumers Power Co. witnesses.

<u>LCRC #4063</u>	SW cor. steel fc. post	North	26.84'	<u>LCRC #6983</u>	SW cor. steel fc. post	N00°E	26.84'
	Remon. tag 20" W. Cherry	N60°E	62.38'		Nail & tag 20" Cher. stump	N60°E	62.47'
	Remon. tag 12" Tw. Cherry	S70°W	79.58'		Nail & tag 16" Cherry	S70°W	80.48'
	Remon. tag 24" W. Cherry	S15°W	89.72'		Nail & tag 24" Cherry	S15°W	89.68'

The selected location is accepted by me and is generally accepted by professional surveyors as the best available evidence of the position of the original corner.

C. Description of monument for corner and accessories established to perpetuate locating the position of the corner:

J-5	Standard Kent County Monument		
	SW corner steel fence corner post	N00°E	26.84'
	Nail & KC Remon. tag SE side 20" Cherry stump	N60°E	62.47'
	Nail & KC Remon. tag S. side 16" Cherry	S70°W	80.48'
	Nail & KC Remon. tag E. side 24" Cherry	S15°W	89.68'
	On fence line to N & S ±		
	On C/L E-W gravel road ±		

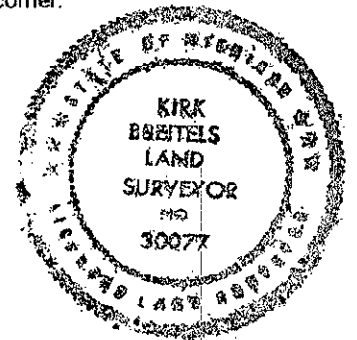

Signed by *Kirk Breitels*
 Surveyor's Michigan License No. 30077

Date 3/27/97

P.A. 345 1990 KENT COUNTY
 PEER APPROVED 3/27/97
 CHAIRMAN *[Signature]*