

SURVEY & REMONUMENTATION

MAR 03 1998

KENT COUNTY REMONUMENTATION

LAND CORNER RECORDATION CERTIFICATE
Filing Requirement of Act 74, Mich. P.A. 1970

SECTION

For corners in
KENT COUNTY

Located In:	Corner Code #
T 5N R 9W	J-9
T R	
T R	
T R	
S T R	
S T R	
S T R	
S T R	

1. Public Land Survey

2. Property Controlling in Section

3. Miscellaneous Property in Sec.

4. Lot No. _____, Recorded Plat _____
5. Private Claims _____

REG. OF DEEDS

Handwritten signature

97 NOV 13 PM 1:01

STATE OF MICHIGAN
COUNTY OF KENT
RECEIVED FOR RECORD

10268

Register of Deeds Stamp & File Number

I, Kirk Breitels, in a field survey on Sept. 5, 1997 do hereby state that under requirements of P.A. 74, Michigan P.A. of 1970, the corner points mentioned in lines 1 and 2 above were in conformance with regulations and rules therefore as required in the current manual of survey instructions of the United States Department of the Interior, Bureau of Land Management or by a decree of a Court of Law and/or that the corner points mentioned in lines 3, 4 and 5 above were in conformance with the rules of the Michigan Board of Land Surveyors or by a Decree of a Court of Law, established, re-established, monumented, recovered, found as expressed below:

NOTE: Not more than 2 corners, all in the same town and range, may be recorded on this certificate.

	A	B	C	D	E	F	G	H	I	J	K	L	M
1													
2	6		5		4		3		2		1		
3													
4	7		8		9		10		11		12		
5													
6	18		17		16		15		14		13		
7													
8	19		20		21		22		23		24		
9													
10	30		29		28		27		26		25		
11													
12	31		32		33		34		35		36		
13													

A. Description of original monument and accessories and/or subsequent restoration:

- J-9 1830---GLO---Mullett---Set Post
- 1939---Kent Co. Wit.---Ford Axle
- "X" on Hdwl WNW 43.0' "X" on Hdwl WSW 49.9' 14" Elm NW 30.65'
- 12" Maple NNE 27.05' 20" Elm SSE 30.15' Fe. post S 30.8'
- 26" Maple SSW 30.0' 14" Maple SW 36.05'
- 1956---Williams & Works---Axle Shaft
- 14" Elm NW 30.65' "X" on Hdwl WNW 43.00' 12" Maple NNE 27.05'
- 18" Elm SSE 30.15' 26" Maple SSW 33.0' 14" Maple SW 36.05'


B. Description of corner evidence found and/or method applied in restoring or reestablishing corner: P.A. 345 1990 KENT COUNTY

- J-9 Found Axle Shaft in Monument Box PEER APPROVED 6/26/97
- Fd. remaining witness: Spike in 48" Maple SSE 33.65' CHAIRMAN Harry Huber
- Fd. capped rod (Jonker) - South 33'
- Meas. E. to SE cor. Sec. 25: 2617.84' - 2618.0' WW 1956

The Axle Shaft in Mon. Box is accepted by me and is generally accepted by professional surveyors as the best available evidence of the original corner.

C. Description of monument for corner and accessories established to perpetuate locating the position of the corner:

- J-9 Set Standard Kent Co. Monument (Harrison) in Mon. Box over top of the Axle Shaft
- Nail & KC Remon. tag N. side 16" Pine N80°E 152.28'
- Large Spike N. side 16" Maple S65°E 104.85'
- Nail & KC Remon. tag W. side 18" Cherry S10°E 51.25'
- Large Spike E. side 48" Maple S25°W 33.65'
- Large Spike SW side 24" Maple N45°W 37.67'
- On C/L E-W asph. rd.

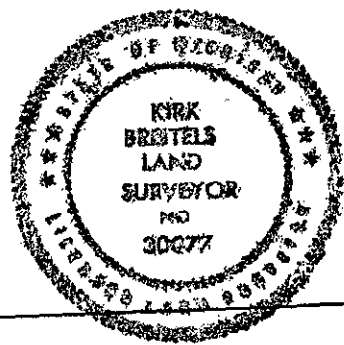

Signed by Kirk Breitels
Surveyor's Michigan License No. 30077

Date 10/30/97