

MAR 03 1998

KENT COUNTY REMONUMENTATION

SECTION

LAND CORNER RECORDATION CERTIFICATE  
Filing Requirement of Act 74, Mich. P.A. 1970

For corners in  
KENT COUNTY

Located In:	Corner Code #
T 5N R 9W	J-12
T R	
T R	
T R	
T R	
S T R	
S T R	
S T R	
S T R	

STATE OF MICHIGAN  
COUNTY OF KENT  
RECEIVED FOR RECORD  
97 NOV 13 PM 1:01  
REG. OF DEEDS  
*Luci J. Bond*

10270

Register of Deeds Stamp & File Number

1. Public Land Survey

2. Property Controlling in Section

3. Miscellaneous Property in Sec.

4. Lot No. \_\_\_\_\_, Recorded Plat \_\_\_\_\_  
5. Private Claims \_\_\_\_\_

Kirk Breitels Sept. 16 97

I, Kirk Breitels, in a field survey on Sept. 16 1997, do hereby state that under requirements of P.A. 74, Michigan P.A. of 1970, the corner points mentioned in lines 1 and 2 above were in conformance with regulations and rules therefore as required in the current manual of survey instructions of the United States Department of the Interior, Bureau of Land Management or by a decree of a Court of Law and /or that the corner points mentioned in lines 3, 4 and 5 above were in conformance with the rules of the Michigan Board of Land Surveyors or by a Decree of a Court of Law; established, re-established, monumented, recovered, found as expressed below:

NOTE: Not more than 2 corners, all in the same town and range, may be recorded on this certificate.

	A	B	C	D	E	F	G	H	I	J	K	L	M
1													
2	6		5		4		3		2		1		
3													
4	7		8		9		10		11		12		
5													
6	18		17		16		15		14		13		
7													
8	19		20		21		22		23		24		
9													
10	30		29		28		27		26		25		
11													
12	31		32		33		34		35		36		
13													

A. Description of original monument and accessories and/or subsequent restoration:  
J-12 1830---GLO---Not Set  
Williams & Works---No information  
Kent Co. Wits.---No information

P.A. 345 1990 KENT COUNTY  
PEER APPROVED 9/25/97  
CHAIRMAN [Signature]


B. Description of corner evidence found and/or method applied in restoring or reestablishing corner:  
J-12 Established Intersection of 1/4 lines and found nothing at corner.

Established location falls on a N-S & W fence line  $\pm$  and is 25'  $\pm$  S. of the N. bank of the Coldwater River.

The Intersection of 1/4 lines is accepted by me and is generally accepted by professional surveyors as the best available evidence of the position of the corner.

C. Description of monument for corner and accessories established to perpetuate locating the position of the corner:  
J-12 Set Standard Kent Co. Monument (Harrison) at the Intersection of 1/4 lines.

- Nail & KC Remon. tag S. side 12" Elm N70°E 10.76'
- Nail & KC Remon. tag E. side 8" Hackberry S00°E 7.48'
- Nail & KC Remon. tag N. side 12" Hackberry S80°W 48.86'
- Nail & KC Remon. tag NE side 6" Maple N45°W 20.96'
- Nail & KC Remon. tag W. side 6" Maple N10°E 6.05'

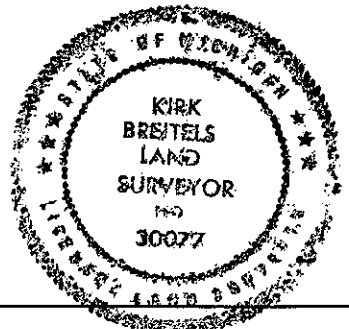

Signed by [Signature]  
an License No. 30077

Date 10/30/97