

**SURVEY & REMONUMENTATION**

MAR 03 1998

KENT COUNTY REMONUMENTATION

SECTION

LAND CORNER RECORDATION CERTIFICATE  
Filing Requirement of Act 74, Mich. P.A. 1970

STATE OF MICHIGAN  
COUNTY OF KENT  
RECEIVED FOR RECORD  
97 APR 29 AM 8:20  
REG. OF DEEDS  
*Lucy Standa*

For corners in

KENT COUNTY

(County)

Located In:

Corner Code #

1. Public Land Survey

T 5N R 9W

K-2

T R

T R

T R

2. Property Controlling in Section

S T R

S T R

3. Miscellaneous Property in Sec.

S T R

S T R

9771

Register of Deeds Stamp & File Number

4. Lot No. \_\_\_\_\_, Recorded Plat \_\_\_\_\_  
5. Private Claims \_\_\_\_\_

I, Kirk Breitels, in a field survey on Jan. 29, 1997 do hereby state that under requirements of P.A. 74, Michigan P.A. of 1970, the corner points mentioned in lines 1 and 2 above were in conformance with regulations and rules therefore as required in the current manual of survey instructions of the United States Department of the Interior, Bureau of Land Management or by a decree of a Court of Law and/or that the corner points mentioned in lines 3, 4 and 5 above were in conformance with the rules of the Michigan Board of Land Surveyors or by a Decree of a Court of Law; established, re-established, monumented, recovered, found as expressed below:

NOTE: Not more than 2 corners, all in the same town and range, may be recorded on this certificate.

	A	B	C	D	E	F	G	H	I	J	K	L	M
1													
2	6		5		4		3		2		1		
3													
4	7		8		9		10		11		12		
5													
6	18		17		16		15		14		13		
7													
8	19		20		21		22		23		24		
9													
10	30		29		28		27		26		25		
11													
12	31		32		33		34		35		36		
13													

A. Description of original monument and accessories and/or subsequent restoration:

K-2	1830	GLO	Mullett	Set Post
	1967	Kent Co. Wit.		3/4" Iron in Mon. Box
	1981	LCRC #1630	Byl	3/4" Iron in Mon. Box
	1982	LCRC #2849	Jonker	Set Kent County Monument in Mon. Box
	1994	LCRC #6985	Byl	Kent County Monument in Mon. Box

The position of this corner was previously approved by the Kent County Remonumentation Peer Group, monumented by Robert J. Jonker on 5/13/82 and was recorded per LCRC #2849

B. Description of corner evidence found and/or method applied in restoring or reestablishing corner:


K-2 Found standard Kent Co. Mon. (Harrison) per witnesses from above LCRC as set by Robert J. Jonker in place of the 3/4" Iron he found over a Stone in a Mon. Box. Said Iron over Stone checks with Kent Co. Wit. and LCRC #1630.

<u>LCRC #2849</u>		<u>LCRC #6985</u>	
Remon. tag P. Pole	N40°W 56.24'	Nail & tag P. Pole	N40°W 56.24'
Remon. tag P. Pole	S20°E 62.73'	Nail & tag P. Pole	S20°E 62.66'
Remon. tag curb joint	S45°W 42.50'	PK Nail in curb joint	S45°W 42.55'
Remon. tag curb joint	N45°E 31.02'	PK Nail in curb joint	N45°E 31.06'
Boat spike (Int. P.I.) West	7.64'	SW cor. gar. fnd.	N45°E 130.08'

The selected location is accepted by me and is generally accepted by professional surveyors as the best available evidence of the position of the original corner.

C. Description of monument for corner and accessories established to perpetuate locating the position of the corner:

K-2	Standard Kent County Monument in Mon. Box		
	Nail & KC Remon. tag NE side P. Pole	N40°W	56.24'
	Nail & KC Remon. tag SW side P. Pole	S20°E	62.66'
	PK Nail in curb joint	S45°W	42.55'
	PK Nail & KC Remon. tag in curb joint	N45°E	31.06'
	SW corner garage foundation	N45°E	130.08'
	Boat spike (Int. P.I.)	West	7.64'

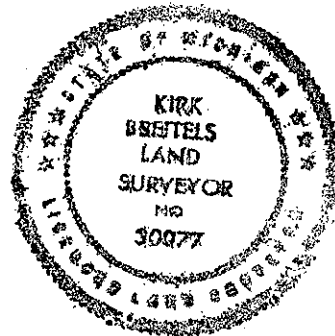

Signed by *Kirk Breitels*  
Surveyor's Michigan License No. 30077

Date 3/27/97

P.A. 345 1990 KENT COUNTY,

PEER APPROVED 3/27/97

CHAIRMAN *Harold Hubert*

FORM APPROVED BY MICHIGAN STATE BOARD OF PROFESSIONAL SURVEYORS, JAN. 28, 1971

REVISED MAY 14, 1975

REVISED JAN., 1983

REVISED OCT., 1995