

SURVEY & REMONUMENTATION

MAR 03 1998

KENT COUNTY REMONUMENTATION

LAND CORNER RECORDATION CERTIFICATE
Filing Requirement of Act 74, Mich. P.A. 1970

For corners in **SECTION**

KENT COUNTY (County)	Located In:	Corner Code #
1. Public Land Survey	T 5N R 9W	K-5
	T R	
	T R	
	T R	
2. Property Controlling in Section	S T R	
	S T R	
3. Miscellaneous Property in Sec.	S T R	
	S T R	

REG. OF DEEDS

Lucy Bond

97 APR 29 AM 8:20

STATE OF MICHIGAN
COUNTY OF KENT
RECEIVED FOR RECORD

97774

Register of Deeds Stamp & File Number

4. Lot No. _____, Recorded Plat _____
5. Private Claims _____

I, Kirk Breitels, in a field survey on Jan. 29, 19 97 do hereby state that under requirements of P.A. 74, Michigan P.A. of 1970, the corner points mentioned in lines 1 and 2 above were in conformance with regulations and rules therefore as required in the current manual of survey instructions of the United States Department of the Interior, Bureau of Land Management or by a decree of a Court of Law and /or that the corner points mentioned in lines 3, 4 and 5 above were in conformance with the rules of the Michigan Board of Land Surveyors or by a Decree of a Court of Law; established, re-established, monumented, recovered, found as expressed below:

NOTE: Not more than 2 corners, all in the same town and range, may be recorded on this certificate.

1	A	B	C	D	E	F	G	H	I	J	K	L	M
2		6		5		4		3		2		1	
3													
4		7		8		9		10		11		12	
5													
6		10		17		16		15		14		13	
7													
8		19		20		21		22		23		24	
9													
10		30		29		28		27		26		25	
11													
12		31		32		33		34		35		36	
13													

A. Description of original monument and accessories and/or subsequent restoration:

K-5	1830	GLO	Mullett	Set Post
	1957	Kent Co. Wit.		5/8" Sq. Iron
	1966	Williams & Works		Iron in Mon. Box
	1984	LCRC #4064	Jonker	Set Kent County Monument in Mon. Box
	1994	LCRC #6988	Byl	Kent County Monument in Mon. Box

The position of this corner was previously approved by the Kent County Remonumentation Peer Group, monumented by Robert J. Jonker on 12/14/84 and was recorded per LCRC #6064

B. Description of corner evidence found and/or method applied in restoring or reestablishing corner:


K-5 Found standard Kent Co. Mon. (Harrison) per witnesses from above LCRC as set by Robert J. Jonker in place of the 1/2" Bolt over a 5/8" Sq. Iron he found inside a Mon. Box. Bolt and Iron check with Kent Co. Wit. and Williams & Works information.

LCRC #4064		LCRC #6988	
Remon. tag P. Pole	N45°W 60.25'	Nail & tag P & T Pole	N45°W 60.22'
Remon. tag P & T Pole	S55°W 58.50'	Nail & tag P & T Pole	S55°W 58.53'
Remon. tag fc. post	S45°E 49.92'	Nail & tag cor. fc. post	S45°E 49.45'
SE cor. brick garage	N40°E 153.07'	SW cor. brick garage	N40°E 153.07'
		Nail & tag 24" Maple	S85°W 99.40'

The selected location is accepted by me and is generally accepted by professional surveyors as the best available evidence of the position of the original corner.

C. Description of monument for corner and accessories established to perpetuate locating the position of the corner:

K-5	Standard Kent County Monument in Mon. Box	
	Nail & KC Remon. tag NE side P & T Pole	N45°W 60.22'
	Nail & KC Remon. tag SE side P & T Pole	S55°W 58.53'
	PK Nail & KC Remon. tag SW side cor. fc. post	S45°E 49.41'
	SW corner brick garage	N40°E 153.07'
	C/L N-S asph. rd. is 1' ± E.	
	On C/L grav. rd. W. and asph. rd. E.	

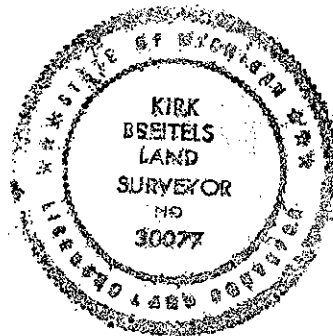

Signed by *Kirk Breitels*
Surveyor's Michigan License No. 30077

Date 3/27/97

P.A. 345 1990 KENT COUNTY
PEER APPROVED 3/27/97
CHAIRMAN *Harry Hubers*