

**SURVEY & REMONUMENTATION**

MAR 03 1998

**KENT COUNTY REMONUMENTATION**

**SECTION**

**LAND CORNER RECORDATION CERTIFICATE  
Filing Requirement of Act 74, Mich. P.A. 1970**

For corners in

KENT COUNTY

(County)

Located In:

Corner Code #

1. Public Land Survey	T <u>5</u> N R <u>9</u> W	K-6
	T ___ R ___	_____
	T ___ R ___	_____
	T ___ R ___	_____
2. Property Controlling in Section	S ___ T ___ R ___	_____
	S ___ T ___ R ___	_____
3. Miscellaneous Property in Sec.	S ___ T ___ R ___	_____
	S ___ T ___ R ___	_____

STATE OF MICHIGAN  
COUNTY OF KENT  
RECEIVED FOR RECORD  
97 OCT 14 AM 10:02  
REC. OF DEEDS  
*Lucy Bond*

**10030**

Register of Deeds Stamp & File Number

4. Lot No. \_\_\_\_\_, Recorded Plat \_\_\_\_\_  
5. Private Claims \_\_\_\_\_

I, Kirk Breitels, in a field survey on June 5, 1997 do hereby state that under requirements of P.A. 74, Michigan P.A. of 1970, the corner points mentioned in lines 1 and 2 above were in conformance with regulations and rules therefore as required in the current manual of survey instructions of the United States Department of the Interior, Bureau of Land Management or by a decree of a Court of Law and /or that the corner points mentioned in lines 3, 4 and 5 above were in conformance with the rules of the Michigan Board of Land Surveyors or by a Decree of a Court of Law; established, re-established, monumented, recovered, found as expressed below:

NOTE: Not more than 2 corners, all in the same town and range, may be recorded on this certificate.

	A	B	C	D	E	F	G	H	I	J	K	L	M
1													
2	6		5		4		3		2		1		
3													
4	7		8		9		10		11		12		
5													
6	18		17		16		15		14		13		
7													
8	19		20		21		22		23		24		
9													
10	30		29		28		27		26		25		
11													
12	31		32		33		34		35		36		
13													

**A. Description of original monument and accessories and/or subsequent restoration:**

K-6 1830---GLO---Mullett---Set Post  
 ---Williams & Works---No information  
 1961---Kent Co. Wit.---3/4" Iron  
 14" Ash W 32.45' 12" Walnut NNW 75.40' Iron fc. post E 24.60'  
 1977---Survey---Consumers Power Co.---3/4" Pipe in Mon. Box  
 Steel fc. post E 27.60' 16" Ash W 32.45' Walnut N25°W 75.40'

**B. Description of corner evidence found and/or method applied in restoring or reestablishing corner:**


K-6 Found 3/4" Iron Pipe in Mon. Box per the following remaining witnesses:  
 Face 30" Ash W 32'± "L" fence post E 27.56'  
 Face 14" dead Walnut NNW 75'± CP Co. capped iron W 32.94'

Iron is 0.5' E. of straight line between NW & SW corners of Sec. 13 and is within 0.3' of midpoint of mile.

The 3/4" Iron Pipe in Mon. Box is accepted by me and is generally accepted by professional surveyors as the best available evidence of the original corner.

**C. Description of monument for corner and accessories established to perpetuate locating the position of the corner:**

K-6 Set Standard Kent Co. Monument (Harrison) in Mon. Box in place of the 3/4" Iron Pipe  
 Set Nail & KC Remon. tag S. side 30" Ash S85°W 32.95'  
 Set Nail & KC Remon. tag E. side P. Pole S15°W 191.90'  
 Set Nail & KC Remon. tag S. side 24" Ash S75°E 29.92'  
 Set Nail & KC Remon. tag E. side 24" Walnut N20°W 87.77'  
 Capped Rerod (CP Co.) West 32.95'

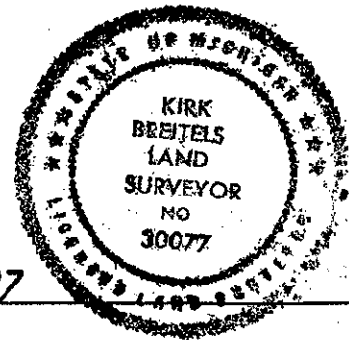

Signed by *Kirk Breitels*  
 Surveyor's Michigan License No. 30077

Date 8/28/97

P.A. 345 1990 KENT COUNTY  
 PEER APPROVED 6/26/97  
 CHAIRMAN *[Signature]*