

**SURVEY & REMONUMENTATION**

MAR 03 1998

KENT COUNTY REMONUMENTATION

**LAND CORNER RECORDATION CERTIFICATE**  
Filing Requirement of Act 74, Mich. P.A. 1970

STATE OF MICHIGAN  
COUNTY OF KENT  
RECEIVED FOR RECORD  
97 APR 29 AM 8:20  
REG. OF DEEDS  
*Luis J. Sand*

For corners in SECTION  
KENT COUNTY  
(County)

Located In: Corner Code #  
T 5N R 9W K-7  
T R  
T R  
T R  
S T R  
S T R  
S T R  
S T R

- 1. Public Land Survey
- 2. Property Controlling in Section
- 3. Miscellaneous Property in Sec.

9775

Register of Deeds Stamp & File Number

- 4. Lot No. \_\_\_\_\_, Recorded Plat \_\_\_\_\_
- 5. Private Claims \_\_\_\_\_

	A	B	C	D	E	F	G	H	I	J	K	L	M
1													
2	6		5		4		3		2		1		
3													
4	7		8		9		10		11		12		
5													
6	18		17		16		15		14		13		
7													
8	19		20		21		22		23		24		
9													
10	30		29		28		27		26		25		
11													
12	31		32		33		34		35		36		
13													

I, Kirk Breitels, in a field survey on Jan. 29, 1997 do hereby state that under requirements of P.A. 74, Michigan P.A. of 1970, the corner points mentioned in lines 1 and 2 above were in conformance with regulations and rules therefore as required in the current manual of survey instructions of the United States Department of the Interior, Bureau of Land Management or by a decree of a Court of Law and /or that the corner points mentioned in lines 3, 4 and 5 above were in conformance with the rules of the Michigan Board of Land Surveyors or by a Decree of a Court of Law; established, re-established, monumented, recovered, found as expressed below:

NOTE: Not more than 2 corners, all in the same town and range, may be recorded on this certificate.

A. Description of original monument and accessories and/or subsequent restoration:

K-7	1830	GLO	Mullett	Set Post
	1957	Kent Co. Wit.		1 1/2" Solid Iron
	1979	LCRC #1270	Bonnema	1/2" Iron in Mon. Box
	1981	LCRC #2252	Jonker	Set Kent County Monument in Mon. Box
	1994	LCRC #6989	Byl	Kent County Monument in Mon. Box

The position of this corner was previously approved by the Kent County Remonumentation Peer Group, monumented by Robert J. Jonker on 11/7/81 and was recorded per LCRC #2252

B. Description of corner evidence found and/or method applied in restoring or reestablishing corner:


K-7 Found standard Kent Co. Mon. (Harrison) per witnesses from above LCRC as set by Robert J. Jonker in place of the 1/2" Iron over a 3/4" Iron he found inside a Mon. Box. Both Irons check with Kent Co. Wit. and LCRC #1270.  
LCRC #2252 LCRC #6989

Remon. tag 10" Cherry	N48°E	66.66'	Nail & tag P. Pole	S56°W	99.93'
Remon. tag 8" Cherry	N10°W	112.68'	NE cor. garage fnd.	S49°E	62.89'
Remon. tag P. Pole	S56°W	99.93'	NE cor. gas station	S06°E	51.40'
NE cor. garage fnd.	S49°E	62.89'	"X" on curb	N35°E	39.22'
NE cor. gas station	S06°E	51.37'	"X" on curb	N40°W	36.38'

The selected location is accepted by me and is generally accepted by professional surveyors as the best available evidence of the position of the original corner.

C. Description of monument for corner and accessories established to perpetuate locating the position of the corner:

K-7	Standard Kent County Monument in Mon. Box		
	Nail & KC Remon. tag NW side P. Pole	S56°W	99.93'
	NE corner garage foundation	S49°E	62.89'
	NE corner frame gas station	S06°E	51.40'
	Chiseled "X" on curb	N35°E	39.22'
	Chiseled "X" on curb	N40°W	36.38'
	Corner is at C/L "T" of intersection ±		

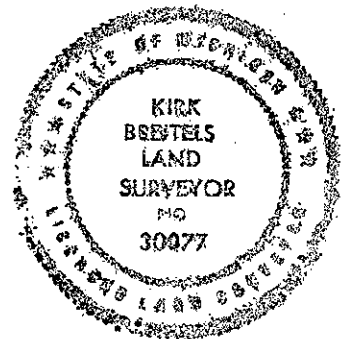

Signed by *Kirk Breitels*  
Surveyor's Michigan License No. 30077

Date 3/27/97

P.A. 345 1990 KENT COUNTY  
PEER APPROVED 3/27/97  
CHAIRMAN *Henry Hubert*